

OREGON CORNER RESTORATION FORM

COUNTY: Umatilla DATE: 3/4/94


CORNER DESIGNATION: J-25. S.E. Corner Section 12, T4N., R36E., W.M..

PREVIOUS RENEWALS/SURVEYS, ETC.: The original survey was made by William H. Odell, under Contract No.114, dated July 2nd, 1866. Odell set a post Cor. for Sec.; 12, 13, 7, & 18, from which:

- A pine, 10 ins. diam. brs. S. 26° W., 275 lks.
A pine, 21 ins. diam. brs. S. 30° W., 275 lks.
A pine, 15 ins. diam. brs. N. 88° W., 375 lks.

MONUMENT & ACCESSORIES FOUND: Found fence corner intersection with fences extending North, South & West from the intersection. There is a small earthen pond a few hundred feet to the East. There is no existing evidence of the original post or bearing trees. After thorough investigation and measuring 1/2 mile to the North to another fence intersection, I accept the fence intersection as the best remaining evidence of the original corner position.

MONUMENT MARKING DETAIL:

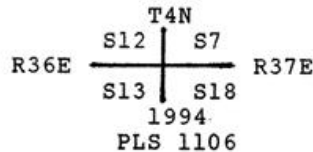

MONUMENT SET: At fence corner intersection, set a 2 1/2" brass cap on a 1 1/4" X 30" galvanized iron pipe, 26" in the ground, with a mound of stone to the cap.

New Accessories:

Set steel guard post with witness sign attached 1.5 feet North of corner monument.

A 5/8"X 30" iron pin with plastic cap stamped:"OR PLS 1106, WA PLS 17372", bears N 09° E, 18.4 feet.

A 5/8"X 30" iron pin with plastic cap stamped:"OR PLS 1106, WA PLS 17372", bears S 3 1/2° E, 16.0 feet.

A 5/8"X 30" iron pin with plastic cap stamped:"OR PLS 1106, WA PLS 17372", bears S 88° W, 17.7 feet.

A 5/8"X 30" iron pin with plastic cap stamped:"OR PLS 1106, WA PLS 17372", bears N 40° W, 21.7 feet.

Attached bearing object signs to iron pins, set steel fence posts near each iron pin and attached witness signs.

LOCATION & COMMENTS: The corner is located in the head of a drainage flowing Northwest.

COMPASS DECLINATION: 18° East

Surveyor's Seal

FIRM/AGENCY: William R. Wells, PLS
P.O. Box 1696
Pendleton, Oregon 97801

REGISTERED
PROFESSIONAL
LAND SURVEYOR

Will. R. Wells

OREGON
JULY 22, 1977
WILLIAM R. WELLS
1106

RENEWS 12-31-94

Party Chief: Robert D. English
Notes: Robert D. English
Witness: F. Scot Munro

RECEIVED BY

Umatilla County Surveyor

Date 7-94

Rec'd By KR

No. 94-73-B