


OREGON CORNER RESTORATION FORM

Section 14 Township 4N Range 36E
 County Umatilla Date: October 28, 2005

Corner Designation: 4N36L17 Condition Report Only
 Not found
 1/4 corner to sections 14 and 15, T4N, R36E W.M. x Remonumented
 Umatilla County, Oregon. Unrecorded
 Surveyed in
x Referenced out

Previous Renewals / Surveys, etc.
 Corner originally set by William H. Odell under contract No. 114 dated July 2, 1866. His record reads: Set basalt stone 9 x 11 x 12 for 1/4 sec. cor. on steep hillside facing the N.

Monument and Accessories found: (condition and source)
 I found an unmarked basalt stone 9" x 8" x 4" at the foot of a 40" diameter Ponderosa Pine stump. The stump was the corner post for a 3 way fence intersection with fences running east, west and south. The stump had a blazed face on the south side that was plainly marked 1/4 S. The stump had wire well grown into it on both the north and south sides.

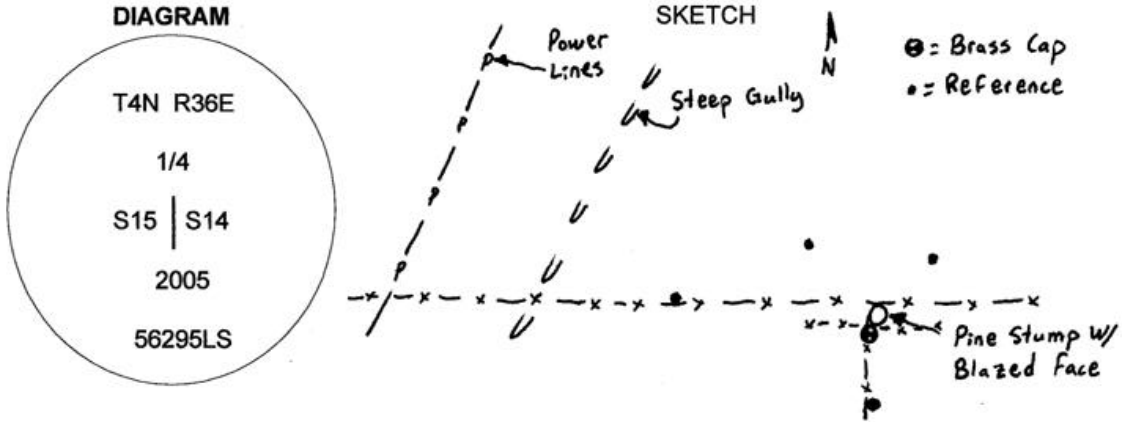

MONUMENT (S) AND ACCESSORIES SET (Procedures and Description)
 I Set a 1 1/4" x 30" Galvanized Iron Pipe with a 2 1/2" brass cap stamped as shown in the diagram above at the point of the stone which was also the oldest fence intersection.

For references, I set four 5/8" by 24" rebars with 1.25" orange plastic caps stamped WTS and 56295LS as described below:
 an iron rebar bears N82°18'04"W, 83.82 feet;
 an iron rebar bears N38°54'12"W, 32.67 feet;
 an iron rebar bears N36°27'05"E, 22.69 feet;
 an iron rebar bears S13°11'40"E, 19.77 feet;

This monument and references were tied using a Trimble R7/R8 RTK GPS.

Location and comments

Compass Declination

Surveyors Seal

RECEIVED BY:
Umatilla County Surveyor
 Date: 11-05
 Rec'd By: KK
 No. 05-198-C

Firm / Agency
 Witness Tree Surveying
 Address
 P.O. Box G
 Pilot Rock, Or. 97868
 Party Chief
 Stephen K, Haddock

REGISTERED PROFESSIONAL LAND SURVEYOR
Stephen K. Haddock
 OREGON
 JULY 9, 2001
 STEPHEN K. HADDOCK
 56295LS
 RENEWAL DATE 6-30-07