

OREGON CORNER RESTORATION FORM

Section 13 Township 4N Range 36E
 County Morrow Date: July 26, 2005

Corner Designation: 4N36L25 Condition Report Only
 Not found
 Remonumented
 Unrecorded
 Surveyed in
 Referenced out



Quarter corner to section 13 only, T4N, R36E, W.M.
 Umatilla County, Oregon.

Previous Renewals / Surveys, etc.

The corner was originally set by William H. Odell under contract No. 110 dated February 7, 1865. His record reads: Set post for 1/4 sec cor.; made stone mound as per instructions. Umatilla County Surveyor John Arnold set a stone for this corner by single proportion under the survey recorded in the Record of Private Surveys, Book 1, Page 181, in June of 1888.

Monument and Accessories found: (condition and source)

I found a fence corner with fences running east and south which appears to have been based on John Arnold's measurements. His measurements had an error of more than 3 chains and as no possessory items in Section 13 have been based on his work I hold the fence corner as applying to Section 18 only. The corner location for Section 13 falls in a plowed field.

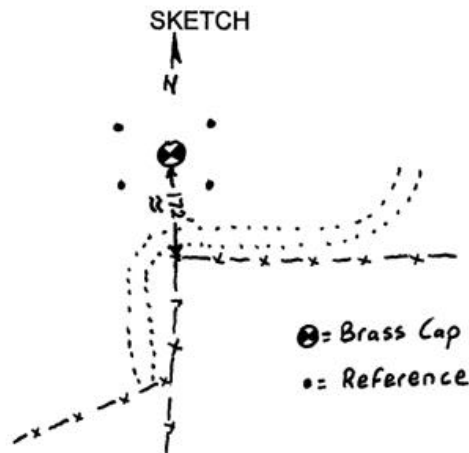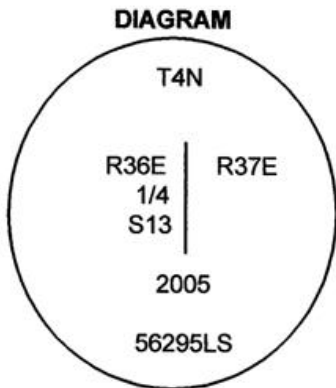

MONUMENT (S) AND ACCESSORIES SET (Procedures and Description)

At the proportionate point I set a 1 1/4" x 30" Galvanized Iron Pipe with a 2 1/2" brass cap stamped as shown in the diagram above 36" in the ground.

For references I set four 5/8" x 24" iron rebars with 1 1/8" orange plastic caps stamped WTS and 56295LS as described below:

- an iron rebar bears N39°25'13"W, 46.72 feet, 6 inches below the surface;
- an iron rebar bears N48°04'29"E, 46.10 feet, 6 inches below the surface;
- an iron rebar bears S49°33'45"E, 42.40 feet, 6 inches below the surface;
- an iron rebar bears S37°46'59"W, 44.06 feet 6 inches below the surface;

The monument was set and references tied using a Trimble R7/R8 RTK GPS

Location and comments

Compass Declination

Surveyors Seal

RECEIVED BY:
 Umatilla County Surveyor
 Date: 11-05
 Rec'd By: KK
 No. 05-198-C

Firm / Agency
 Witness Tree Surveying
 Address
 P.O. Box G
 Pilot Rock, Or. 97868
 Party Chief
 Stephen K, Haddock

**REGISTERED
 PROFESSIONAL
 LAND SURVEYOR**

Stephen K. Haddock

OREGON
 JULY 9, 2001
 STEPHEN K. HADDOCK
 56295LS

RENEWAL DATE 6-30-07