

OREGON CORNER RESTORATION FORM

COUNTY: Umatilla. DATE: 10/17/19.

CORNER DESIGNATION: P-11, The Center 1/4 corner of Section 21, Township 4 North, Range 36 East, W.M.

PREVIOUS RENEWALS/SURVEYS ETC: No record was found for establishment of this corner point but it's location relative to the accepted North and South 1/4 corner of Section 21 indicate it was located by survey sometime in the past.

MONUMENT AND ACCESSORIES FOUND: Accepted ancient fence corner with old fences extending North-South and West.

MONUMENT MARKING DETAIL:

T4N R36E	NAD 83 (2011) epoch 2010.00 Coordinates
1/4	International feet units:
C-----C	N: 788529.80
S21	E: 8756436.62
2019	
PLS 1106	

MONUMENT SET: At the base of an old round post fence corner, set a 5/8 by 24" rebar with 2" aluminum cap 18" in the ground to refusal. Cap is marked as shown in "Monument Marking Detail".

New accessories:

- A 5/8 by 24" rebar with 1 1/4" red plastic cap bears N 02° E, 14.0', set in fence.
- A 5/8 by 24" rebar with 1 1/4" red plastic cap bears N 02° E, 29.5', set in fence.
- A 5/8 by 24" rebar with 1 1/4" red plastic cap bears S 49° W, 22.5'.
- A 5/8 by 24" rebar with 1 1/4" red plastic cap bears S 01° E, 16.9', set in fence.

Red plastic caps are marked "ORPLS 1106 WAPLS 17372". Rebar accessories have "bearing object" signs wired to them.


Nailed a "Witness" sign to round post fence corner at the corner monument point.

LOCATION AND COMMENTS: Corner is located on a East facing slope, in rocky ground at a fence corner with fences extending North-South and West. Used Spencer tape and compass with 14° East declination to measure to corner accessories.


FIRM: Wells Surveying
P.O. Box 1696
Pendleton, OR 97801

\4N36P-11

Surveyor's Seal

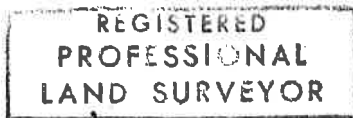

William R. Wells

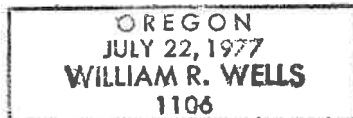

renews 6-30-20

20-027-R