

USDA-FOREST SERVICE

Index File No. L-13

04M (Bce)

CORNER RECORD (SEARCH)
(Ref. FSM 7151.4)

Tract or Survey No. _____

Cor. No. L-13

T 4 N R. P7E

R.D. _____


County _____

Merid. William-tfv

N.F. _____

State Oregon

CORNER DIAGRAM

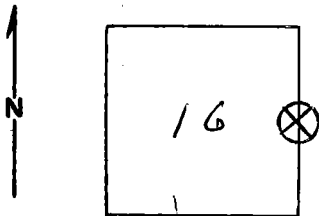

DESCRIBE CORNER MONUMENT FOUND

No NE

DESCRIBE BEARING TREES OR OTHER OFFICIAL ACCESSORIES FOUND

*BT 10" PP stump visible BT
32" PP stump*

PHOTO IDENTIFICATION DATA

Photo No. _____

Filed At. _____

Object Ident. _____

Ident. By _____

Signature

PLANE COORDINATE POSITION DATA

State _____ Zone _____

X _____

Y _____

Estab. By _____

Agency

DESCRIBE CORNER LOCATION RELATIVE TO NEAR-BY FEATURES, ALSO HOW TO REACH CORNER

Signature

RM E EMM

Title

Division

Headquarters

Date

1976

7100-52-(3/68)

CORNER RECORD (PERPETUATION)

MONUMENT: DESCRIBE NEW MONUMENT SET, OR WORK DONE TO PRESERVE EXISTING MONUMENT

set pile of rock

ACCESSORIES : DESCRIBE NEW BT'S WITNESS OBJECTS ETC. ESTABLISHED, OR WORK DONE TO PRESERVE EXISTING EVIDENCE

Work Done By _____ Title _____ Date _____ State Registration No. or Agency _____

Certified Cor. Record Prepared ? Yes No Filed At: _____ Date _____

REMARKS

Index File No. T. R. M. Tract or Surv. No. Cor. U.S. G.P.O. 1977-725-576/586