

CERTIFIED RECORD OF LAND CORNER MONUMENTATION

HISTORY OF ORIGINAL CORNER ESTABLISHED:

Corner was originally established under GLO contract number No. 733 executed by U.S. Deputy Surveyors, Charles L. and William C. Campbell, dated March, 1901. Surveyor General field notes state:

The point for 1/4Sec. Cor. falls on ledge, 2x2x1 ft. above ground. I mark a cross at the exact cor. point, for 1/4 Sec. Cor. and mark 1/4 on W. side of cross, from which:
A Fir, 10 ins. diam. brs. South 82°30' East, 42 lks. dist., marked 1/4 S 13 BT.

A Fir 8 ins. diam. brs. North 7° West, 21 lks. dist. marked 1/4 S14 BT.

In Survey Number No. 00-250-C, Greg E. Flowers found no remaining evidence of the original GLO corner and sets the corner by proportion. Umatilla County monumentation record states: At the position determined by survey, set a 1"x30" galvanized iron pipe 28" in the ground with a 2 1/2" brass cap attached. Set 6' steel fence post 3' North of corner.


16" Ponderosa pine bears, North 8° East, a dist. of 36.00 ft., marked 1/4 S13 BT.

16" Ponderosa pine bears, South 15° East, a dist. of 40.00 ft., marked 1/4 S13 BT.

5/8"x30" rebar with a yellow plastic cap stamped "TOMKINS SURVEYING" bears West, a dist. of 10.00 ft.

24" Ponderosa pine bears North 28° West, a dist. of 25.00 ft marked 1/4 S14 BT

T 4N R 37 E L-21

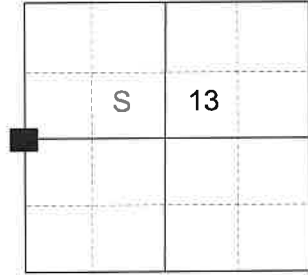

DESCRIPTION OF CORNER EVIDENCE FOUND:

Found a 1" galvanized pipe with a 2 1/2" brass cap, marked as shown below, 4" above ground, from which:

A 19" Douglas Fir bears North 8° East, a dist. of 36.00 ft dead and standing with healed blaze.

A 16" Douglas Fir bears South 15° East, a dist. of 40.00 ft dead standing with healed blaze.

A 5/8" iron pin with yellow plastic cap marked "TOMKINS SURVEYING" bears, West, a dist. of 10.00 ft. with Post aprox. 1' Southwest.

A 25" Douglas Fir bears North 28° West, a dist. of 25.00 ft., alive and vigorous with healed blaze.

DESCRIPTION OF MONUMENT AND ACCESSORIES I ESTABLISHED TO REHABILITATE THE MONUMENT AT THE ORIGINAL LOCATION OF THIS CORNER:

From iron pipe monument,

NEW BEARING OBJECTS:


A 15" Douglas Fir bears, North 16° East, a dist. of 25.90 ft, marked 1/4 S13 BT

A 21" Douglas Fir bears, South 60° East, a dist. of 83.20 ft, marked 1/4 S13 BT

I hereby certify that the corner was perpetuated on August 23, 2021
Witnesses: Kyle Tucker, Emmitt Ambert



Renewal Date: June 30, 2023

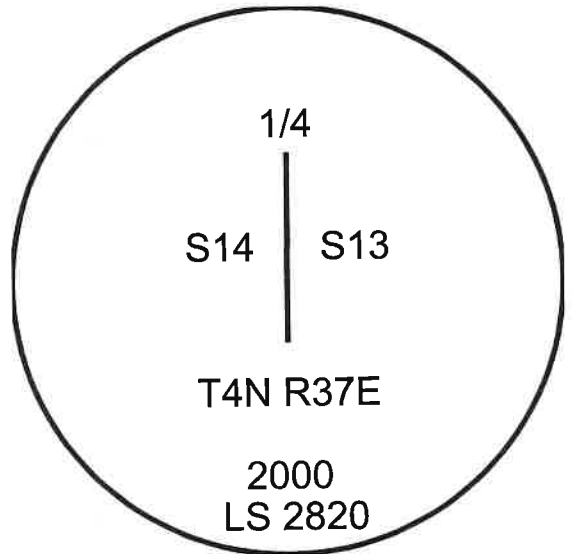

I used a steel tape and magnetic compass in the establishment of the new accessories. The distances are to a 60d spike driven into the right side of the root crown of the bearing trees. A brass washer marked OPLS 83571 is attached to the BT blaze of the new bearing trees.