


CERTIFIED RECORD OF LAND CORNER MONUMENTATION

HISTORY OF ORIGINAL CORNER ESTABLISHED:

Corner not previously established.


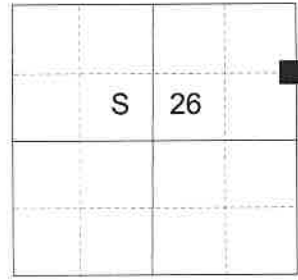

DESCRIPTION OF CORNER EVIDENCE FOUND:

None.

DESCRIPTION OF MONUMENT AND ACCESSORIES I ESTABLISHED TO MONUMENT THE ORIGINAL LOCATION OF THIS CORNER:

At position determined by survey, I set a 5/8" x 30" iron pin, 28" in the ground, with a 2 1/2" aluminum cap, marked as shown below, from which:

NEW BEARING OBJECTS:

A 3" diam. Douglas Fir bears North 77° East, a distance of 10.35 feet, marked X BT.


A 5" Douglas Fir bears North 32° West, a distance of 47.95 feet, marked N 1/16 S26 BT.

Set steel fencepost 0.5 feet West.

Falls on East aspect of North/South running ridge line.

I hereby certify that the corner was monumented on October 9, 2024.

Witnesses: Kyle Tucker

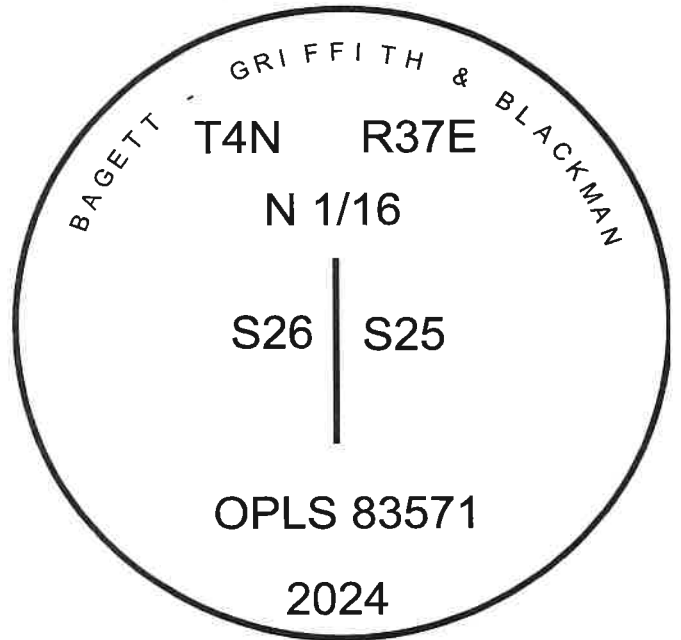

REGISTERED
PROFESSIONAL
LAND SURVEYOR



OREGON
June 2, 2010
JEFFREY S. HSU
83571

Renewal Date: June 30, 2025

I use a tape and compass in the establishment of the new bearing objects. I use 14° East declination. Bearings are measured to a brass washer labeled "OPLS 83571" in the BT blaze at the base of the tree. Distances are to a 60D nail in the right side of the base of the center of the tree.

24-104-B