


**CERTIFIED RECORD OF LAND CORNER MONUMENTATION**

**HISTORY OF ORIGINAL CORNER ESTABLISHMENT:**

Corner not previously established.

T4N R37E X-08

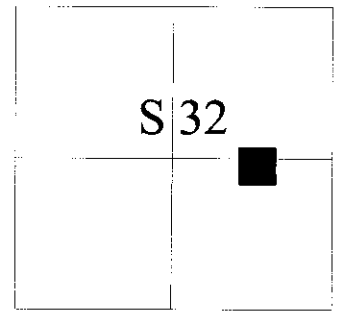

**DESCRIPTION OF CORNER EVIDENCE FOUND:**

None.

**DESCRIPTION OF MONUMENT AND ACCESSORIES I ESTABLISHED**

**TO PERPETUATE THE ORIGINAL LOCATION OF THIS CORNER:**

At position determined by survey, I set a 5/8" x 30" iron pin with a 2 1/2" aluminum cap marked as shown below, 30 inches in the ground, from which:

A 7 inch Larch bears North 28° East, a distance of 12.20 feet, marked CE S32 BT.

A 13 inch Ponderosa Pine bears South 45° West, a distance of 2.48 feet, marked CE S32 BT

I hereby certify that the corner was monumented on July 10<sup>th</sup>, 2013.

Witness: Daniel Inloes

REGISTERED  
PROFESSIONAL  
LAND SURVEYOR



OREGON  
June 2, 2010  
JEFFERY S. HSU  
83571

Renewal Date: June 30, 2015

BAGETT - GRIFFITH & BLACKMAN

T44 R37E

E1/16

C ——— C

S32

2013

OPLS  
83571

I used a steel tape and magnetic compass in the establishment of the new accessories. I use 16° East declination. The distance to the new bearing trees are to a 60d spike driven into the right side of the root crown of the bearing trees. Attached brass washer marked OPLS 83571 to BT Blaze.

**RECEIVED BY**  
Umatilla County Surveyor  
Date: 8/9/2013  
Rec'd By: [Signature]  
No.: 13-213-C