


CERTIFIED RECORD OF LAND CORNER MONUMENTATION

HISTORY OF ORIGINAL CORNER ESTABLISHMENT:

Originally established by George S. Pershin, U.S. Deputy Surveyor, under Contract No. 304, Dated September 19, 1878, from which original notes state:

T 4 N R 37 E Z - 11

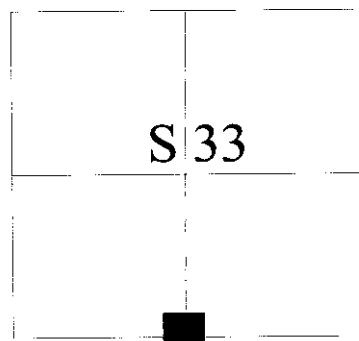

Set fir post on level for 1/4 Section corner from which:

- A Tamarack 22" in diameter bears N30°E, a distance of 10 links;
- A Fir 6" in diameter bears S65°W, a distance of 11 links.

In 1978 Douglas M. Ferguson used proportionate measurements to re-establish the 1/4 corner at which he set a 2" iron pipe with a 2 1/2" brass cap 3" above the surface of the ground from which:

- A Fir 7" in diameter bears N53°E, a distance of 60.55 feet, scribed 1/4S S33 BT;
- A Fir 9" in diameter bears S65°W, a distance of 40.66 feet, scribed 1/4S S4 BT.

In 1991 William R. Wells found set a steel fence post East of the monument and attached a witness corner sign. Wells marked two new bearing trees with bearing object signs:

- A Douglas Fir 9" in diameter bears N46°W, A distance of 27.7 feet, scribed 1/4 S33 BT;
- A Western Larch 9" in diameter bears N32 1/2°E, a distance of 31.6 feet, scribed 1/4 S33 BT.

DESCRIPTION OF CORNER EVIDENCE FOUND:

Found a 2 1/2" brass cap on a 2 1/2" iron pipe 2" above ground level marked as shown below from which:

- A Douglas Fir 23" in diameter bears N55°E, a distance of 60.6 feet, alive and vigorous with healed blaze;
- A White Fir 18" in diameter bears S67°W, a distance of 40.7 feet, alive and vigorous with healed blaze.

DESCRIPTION OF MONUMENT AND ACCESSORIES I ESTABLISHED

TO PERPETUATE THE ORIGINAL LOCATION OF THIS CORNER:

NEW BEARING OBJECTS:


- A White Fir 6" in diameter bears South 49° East, a distance of 14.15 feet, marked 1/4 S4 BT;
- A White Fir 9" in diameter bears North 37° West, a distance of 23.10 feet, marked 1/4 S33 BT.

A fence corner falls 1.5 feet Southwest of the found monument. The fence runs South and West.

I hereby certify that the above corner point was perpetuated on June 26, 2013
Witness: Daniel O. Inloes



Renewal Date: June 30, 2015

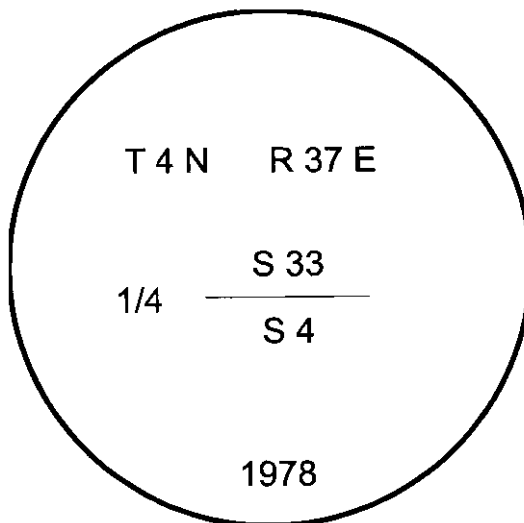

RECEIVED BY
Umatilla County Surveyor
Date: 8/9/2013
Rec'd By: [Signature]
No.: 13-213-C

I used a steel tape and magnetic compass in the establishment of the new accessories. I use 16° East declination. The distance to the new bearing tree is to a 60d spike driven into the right side of the root crown of the bearing trees. Attached brass washer marked OPLS 83571 to BT Blaze.