

72

Index
File No. I-21


CORNER RECORD (SEARCH)
(Ref. FSM 7151.4)

Tract or Survey No. _____
Cor. No. 7

T KN R. 38E R.D. W.W. County Umatilla

Merid. Willamette N.F. Umatilla State Oregon

CORNER DIAGRAM

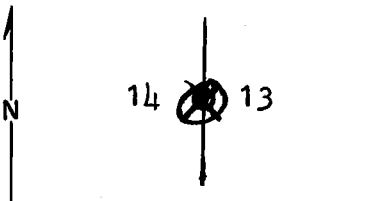

DESCRIBE CORNER MONUMENT FOUND

Corner stone scribed $\frac{1}{4}$ on West face

DESCRIBE BEARING TREES OR OTHER OFFICIAL ACCESSORIES FOUND


BT - White fir. 11" DBH. 15' N 16° E of corner
BT - Alpine fir. Dead and down with visible scribing.
9' 53 $\frac{1}{4}$ ° W. of corner.

PHOTO IDENTIFICATION DATA

Photo No. _____
Filed At. _____
Object Ident. _____
Ident. By _____
Signature

DESCRIBE CORNER LOCATION RELATIVE TO NEAR-BY FEATURES, ALSO HOW TO REACH CORNER

Found corner by pacing from sec. cor

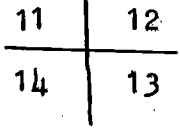

PLANE COORDINATE POSITION DATA

State _____ Zone _____
X _____
Y _____
Estab. By _____
Agency

OB Wood

Forester Title Division 111 Headquarters W.W. Date 9/71

CORNER RECORD (PERPETUATION)

MONUMENT: DESCRIBE NEW MONUMENT SET, OR WORK DONE TO PRESERVE EXISTING MONUMENT

Placed square stake over corner with location poster on it.

ACCESSORIES : DESCRIBE NEW BT's WITNESS OBJECTS ETC. ESTABLISHED, OR WORK DONE TO PRESERVE EXISTING EVIDENCE

Painted scribing on both BT's and placed BT posters on live BT.

Work Done By. _____ Title _____ Date _____ State Registration No. or Agency _____

Certified Cor. Record Prepared ? Yes No Filed At: _____ Date _____

REMARKS

Index File No. L-21 T. R. M. Tract or Surv. No. Cor. 12 13