

USDA-FOREST SERVICE

Index File No. V-12

T 4N R. 38E

Merid. Will

CORNER RECORD (SEARCH)


(Ref. FSM 7151.4)

R.D. Walla Walla County Umatilla

N.F. Umatilla State OR

Tract or Survey No. _____ Cor. No. _____

CORNER DIAGRAM

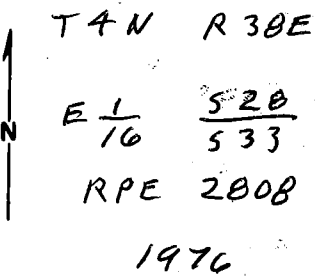

DESCRIBE CORNER MONUMENT FOUND

2" Iron pipe with 2 1/2" B.C. 2" Below Surface
 stamped as Diagram
 A steel fence post 05 ft. West

DESCRIBE BEARING TREES OR OTHER OFFICIAL ACCESSORIES FOUND

a 11" spruce snag bears N 30° W 24.3 ft.
 Some mks visible
 a 14" spruce bears S 44° W 33.3 ft. E 1/10 533 BT
 Visible

PHOTO IDENTIFICATION DATA

Photo No. _____
 Filed At. _____
 Object Ident. _____
 Ident. By _____
 Signature _____

DESCRIBE CORNER LOCATION RELATIVE TO NEAR-BY FEATURES, ALSO HOW TO REACH CORNER

From Jct Rd # 6401 with # 64
 Go East on Rd # 64 0.7 mile
 Corner lies 1050' North of 54-6 on
 wood sign post
 Corner lies 390' North of Elect. Trans.
 Line

PLANE COORDINATE POSITION DATA

State _____ Zone _____
 X _____
 Y _____
 Estab. By _____
 Agency _____

Signature G.D. Edward

Title LS 951

Division _____

Headquarters Hermiston

Date 7/19/85

7100-52 (3. 68)

CORNER RECORD (PERPETUATION)

MONUMENT: DESCRIBE NEW MONUMENT SET, OR WORK DONE TO PRESERVE EXISTING MONUMENT

Attached 54-9 sign to Fence post

ACCESSORIES: DESCRIBE NEW BT'S WITNESS OBJECTS ETC. ESTABLISHED, OR WORK DONE TO PRESERVE EXISTING EVIDENCE

a 8" spruce bears. N 89° E 30.6 ft. Scribed. E 1/16 S 28 BT
nailed Alum tag stamped 951 to Btm of Blaze and
painted Blaze red.
Painted red band around BT's & nailed. 54-3 & 54-9 signs on.

Work Done By G.O. Edwards Title LS Date 7/19/85 State Registration No. OR 951
or Agency

Certified Cor. Record Prepared? Yes No Filed At: Pendleton Date 7/19/85

REMARKS

Index File No. V-12 T. 4N R. 38E M. 111 Tract or Surv. No. Cor. 1/16

Index
File No. V 12

CORNER RECORD (SEARCH) (Ref. FSM 7151.4) Tract or Survey No. _____ Cor. No. V 12

T 4 N R. 38 E R.D. Walla Walla County Umatilla

Merid. Willamette N.F. Umatilla State Oregon

CORNER DIAGRAM

↑
N

T 4 N R 38 E
1 S 28
E ————
16 S 33
RPE 2808

1976

DESCRIBE CORNER MONUMENT FOUND

DESCRIBE BEARING TREES OR OTHER OFFICIAL ACCESSORIES FOUND

PHOTO IDENTIFICATION DATA

Photo No. _____

Filed At. _____

Object Ident. _____

Ident. By _____

Signature _____

PLANE COORDINATE POSITION DATA

State _____ Zone _____

X _____

Y _____

Estab. By _____

Signature
James D. Hanley

Title

Division
ORPE 2808

Headquarters

Date
7/14/76

7100-52 (3/68)

5

CORNER RECORD (PERPETUATION)

MONUMENT: DESCRIBE NEW MONUMENT SET, OR WORK DONE TO PRESERVE EXISTING MONUMENT

Set a 2½" brass cap on a 2" iron pipe 31" long 2" below road surface with a 6' steel fence post 2' west and with signs 54-4 and 54-2 attached.

ACCESSORIES : DESCRIBE NEW BT'S WITNESS OBJECTS ETC. ESTABLISHED, OR WORK DONE TO PRESERVE EXISTING EVIDENCE

A spruce 11" diam. bears N 30° W., 24.3 ft. dist. marked EL/16 S 28 BT
A spruce 14" diam. bears S 44° W., 33.3 ft. dist. marked EL/16 S 33 BT

Each BT has a sign 54-3 attached 6" below a band of red paint and has a brass washer marked RPE 2808 nailed flush with BT blaze.

Work Done By James D. Hanley Title Engineer Date 7/14/76 State Registration No. ORPE 2808
or Agency

Certified Cor. Record Prepared? Yes Filed At: Fondleton, Oregon Date 8/ /76

REMARKS

Index File No. V 12 T. 4 N R. 38 E WM.

Tract or Surv. No.

Cor.

12

13