


CERTIFIED RECORD OF LAND CORNER MONUMENTATION

History of original corner establishment:

Corner originally established by Donald L. Staebler by survey dated 12-13-74 done for Keith Adams Survey is filed in the Umatilla County Survey records as survey number I-156-B

A brass cap monument was set at the corner point.

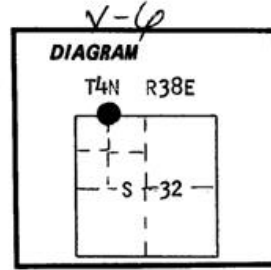

Description of corner evidence found:

Found hole where the original monument was set. The monument has been removed.

Description of monument and accessories established to perpetuate the original location of this corner: At corner position determined by survey, I set a 2 1/2 inch x 30 inch aluminum pipe with aluminum cap marked as shown, 26 inches in the ground, from which:

New BTs

- A 10 inch diameter spruce bears S60°W 10.6 feet marked X BT
- A 10 inch diameter spruce bears N44°W 19.7 feet marked W1/16 S29 BT

Set steel fencepost approximately 5 feet East with 54-2 and 54-9 signs attached


Corner position falls in the above mentioned hole

Corner was set July 29, 1985

Witnesses: Rick Robinson and Stratton French

See map of survey dated July, 1985

I used a steel tape and magnetic compass in the establishment of these accessories. I used 20° East magnetic declination and the distances to the BTs are to the center of the tree. I attached a brass washer marked OPLS 991 to the BT blaze. I attached 54-3 and 54-9 signs to the BTs and painted a 6 inch red band around them.

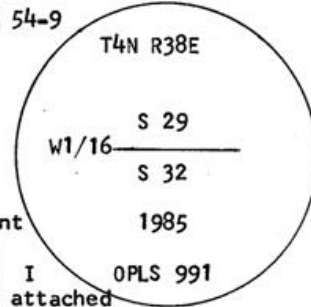

REGISTERED PROFESSIONAL LAND SURVEYOR

*Gregory T. Blackman*

OREGON JULY 13, 1973 GREGORY T. BLACKMAN 991

Office of..... County of.....  
 State of....., I hereby certify that the within instrument was filed in this office  
 for record on the..... day of....., 19.....  
 ..... by .....  
 (COUNTY OFFICIAL) (DEPUTY)

Form R6-7100-57 (9/71)

RECEIVED BY  
 Umatilla County Surveyor  
 Date 8-2-85  
 Rec'd By KA  
 No. 85-94-R