

USDA-FOREST SERVICE


Index  
 File No. X-6  
 T 4N R. 38E  
 Merid. Willamette

CORNER RECORD (SEARCH)

(Ref. FSM 7151.4)

Tract or Survey No. \_\_\_\_\_  
 Cor. No. X-6  
 R.D. WALLA WALLA County LIMATILIA  
 N.F. LIMATILIA State OREGON

CORNER DIAGRAM

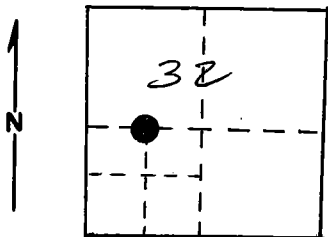

DESCRIBE CORNER MONUMENT FOUND

END 1 1/4" PIPE SET BY MUNNIS

DESCRIBE BEARING TREES OR OTHER OFFICIAL ACCESSORIES FOUND

A 15" SPRUCE (NOW 18") BEARS N73W 22.16 FT  
A 16" SPRUCE BEARS N12E (RECORD N8E) 5.84 FT.

PHOTO IDENTIFICATION DATA

Photo No. \_\_\_\_\_  
 Filed At. \_\_\_\_\_  
 Object Ident. \_\_\_\_\_  
 Ident. By \_\_\_\_\_  
 Signature \_\_\_\_\_

PLANE COORDINATE POSITION DATA

State \_\_\_\_\_ Zone \_\_\_\_\_  
 X \_\_\_\_\_  
 Y \_\_\_\_\_  
 Estab. By \_\_\_\_\_  
 Agency \_\_\_\_\_

DESCRIBE CORNER LOCATION RELATIVE TO NEAR-BY FEATURES, ALSO HOW TO REACH CORNER

AT THE INTERSECTION OF THE POSTED CENTRAL LINE OF SECTION 5 HWY 204, WALK WESTERLY 1000 FEET TO CORNER.

Signature Alroy T. Blakemore

Title Surveyor

Division \_\_\_\_\_

Headquarters \_\_\_\_\_

Date \_\_\_\_\_

7100-52 (3-68)

7-85

CORNER RECORD (PERPETUATION)

MONUMENT: DESCRIBE NEW MONUMENT SET, OR WORK DONE TO PRESERVE EXISTING MONUMENT

Placed Aluminium monument over 1 1/4 Pipe - set fence post  
50 SOUTH & 50 EAST OF CORNER. PLACED ATTN. SIGN ON EAST  
POST.

ACCESSORIES : DESCRIBE NEW BT'S WITNESS OBJECTS ETC. ESTABLISHED, OR WORK DONE TO PRESERVE EXISTING EVIDENCE

A 12" SPRUCE BEARS S 82 E 48.5 FEET MARKED X BT.

A 23" SPRUCE BEARS S 31 E 37.9 FEET MARKED CW 1/16  
S 32 BT.

PLACED LAND SURVY MON. SIGN & BT SIGNS ON NEW BT'S - PAINTED  
NEW BT'S WITH RED BAND

Work Done By Greg Blackum Title Surveyor Date 7-85 State Registration No. OPLS 991  
or Agency

Certified Cor. Record Prepared?  Yes  No Filed At: UMATILLA County Surveyor Date 7-85

REMARKS

Index File No. X-6 T. 4N R. 38E M. Willamette Tract or Surv. No.

Cor. 1/16