


CERTIFIED RECORD OF LAND CORNER MONUMENTATION

History of original corner establishment:

Corner established this survey

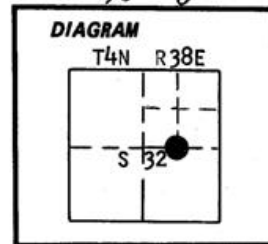

Description of corner evidence found:

NONE

See map of survey dated July, 1985, filed with the Umatilla County Surveyor


Description of monument and accessories I established to perpetuate the original location of this corner: At surveyed position, I set a 2½ inch x 30 inch aluminum pipe with aluminum cap marked as shown, 24 inches in the ground and raised a mound of stone around monument. Corner falls on the toe of the fill on the South side of Highway 204. From which:

New BTs

A 22 inch diameter Spruce bears N31°E 94.3 feet marked CE 1/16 S32 BT on a single blaze
A 6 inch diameter Spruce bears N87°E, 24.0 feet marked X BT on a single blaze

Set a steel fencepost approximately 5 feet East with 54-2 and 54-9 signs attached
Set a 4"x4" wood post with wooden forest boundary sign approximately 8 feet North

Corner set July 12, 1985
Witness: Rick Robinson

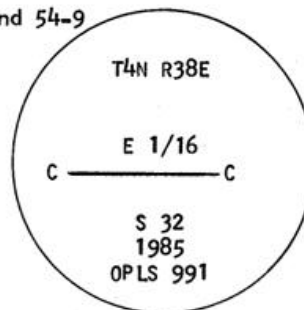

**REGISTERED
PROFESSIONAL
LAND SURVEYOR**

Gregory T. Blackman

OREGON
JULY 13, 1973
GREGORY T. BLACKMAN
991

I used a steel tape and magnetic compass in the establishment of these accessories. I used 20° East magnetic declination and the distances are to the center of the trees. I set a brass washer marked OPLS 991 by the BT blaze. I painted a 6 inch red band around BTs and attached 54-3 and 54-9 signs

Office of..... County of.....
State of....., I hereby certify that the within instrument was filed in this office
for record on the..... day of....., 19.....
..... by
(COUNTY OFFICIAL) (DEPUTY)

Form R6-7100-57 (9/71)

RECEIVED BY

Umatilla County Surveyor

Date 7-24-85

Rec'd By KA

No. 85-83-R

(81-B)