


CERTIFIED RECORD OF LAND CORNER MONUMENTATION

G - 13
DIAGRAM

History of original corner establishment:

The original corner was established by George S. Pershin on June 16, 1882, under GLO contract No. 430, as follows:

Set a basalt stone, 18" x 10" x 6", on south slope, in a mound of stone, marked "1/4" on west face, for the 1/4 section corner.

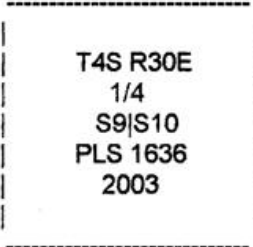

Original corner evidence recovered:


Found the original corner stone solidly set on the southeast edge of a mound of stones, but tipped to the north. The corner stone is 18" x 11" x 7" and is plainly marked "1/4" on the west face.

Monument and accessories established to perpetuate the original position of this corner:

In place of the original corner stone, I set a 1" x 15" flared, galvanized iron pipe 10" into the ground to bedrock. A 2 1/2" brass cap attached to the top of the pipe is marked as shown in the diagram above. I bury the corner stone along the north side of the pipe and build a mound of stones around the pipe, from which:

- A 5/8" x 18" iron rod set 14" into the ground to refusal, with a 3/4" brass washer, marked "PLS 1636 NE", attached at ground level, bears N66° E, 121.0 feet.
- A 5/8" x 18" iron rod set 14" into the ground to refusal, with a 3/4" brass washer, marked "PLS 1636 SE", attached at ground level, bears S40° 30' E, 113.1 feet. This reference is 1.0 foot north of a wire fence projecting N80° W and S80° E.
- A 5/8" x 18" iron rod set 15" into the ground to refusal, with a 3/4" brass washer, marked "PLS 1636 SW", attached at ground level, bears West, 115.1 feet.
- A 5/8" x 18" iron rod set 14" into the ground to refusal, with a 3/4" brass washer, marked "PLS 1636 NW", attached at ground level, bears N36° W, 89.1 feet.

I hereby certify the above corner point was perpetuated as hereon described on June 26, 2003. Magnetic declination set in compass: 17° E.
NAD '83 UTM Zone 11 position: 5011198N, 336278E (plus or minus two meters).

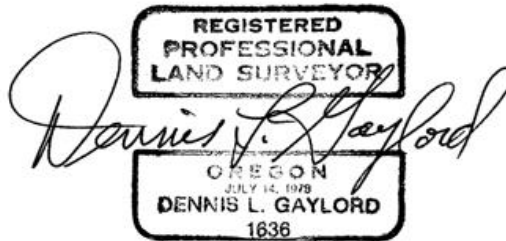

Renews June 30, 2005

Recorded at the office of County Surveyor, County of Umatilla, State of Oregon, on:

RECEIVED BY
Umatilla County Surveyor
Date 8-03
Rec'd By KK
No. 03-135-R