

USDA-FOREST SERVICE

Index
File No. K-18

CORNER RECORD (SEARCH)

(Ref. FSM 7151.4)

Tract or
Survey No. _____ No. _____


T 45 R. 30E

R.D. Ukiah County Umatilla

Merid. Willamette

N.F. Umatilla State Oregon

CORNER DIAGRAM

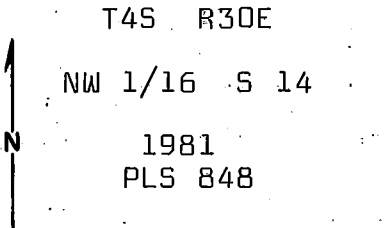

DESCRIBE CORNER MONUMENT FOUND

Corner not previously established.

DESCRIBE BEARING TREES OR OTHER OFFICIAL ACCESSORIES FOUND

N/A

PHOTO IDENTIFICATION DATA

Photo No. _____
Filed At _____
Object Ident. _____
Ident. By _____
Signature

DESCRIBE CORNER LOCATION RELATIVE TO NEAR-BY FEATURES, ALSO HOW TO REACH CORNER

Corner on nearly level ground in open glade.
Primitive road, running NW approx. 150 ft.
South from corner.

PLANE COORDINATE POSITION DATA

State _____ Zone _____
X _____
Y _____
Estab. By _____
Agency

Signature

Title
PLS 848

Division

Headquarters
Mt. Vernon, Or.

Date
7/31/81

7100-52-13/68)

CORNER RECORD (PERPETUATION)

GPO 902-673

MONUMENT: DESCRIBE NEW MONUMENT SET, OR WORK DONE TO PRESERVE EXISTING MONUMENT

Set 3"x30" galv. iron pipe with 3" brass cap stamped as shown on the diagram, set 18 in. in the ground and raised a mound of earth around the pipe.


From which:

ACCESSORIES : DESCRIBE NEW BT'S WITNESS OBJECTS ETC. ESTABLISHED, OR WORK DONE TO PRESERVE EXISTING EVIDENCE

A pine 22 in. dia. bears N6°E, 84.5 ft. scribed NW 1/16 S 14 BT.
 A pine 12 in. dia. bears S19°W, 87.8 ft. scribed NW 1/16 Sec. 14 BT.
 Set steel posts with warning and boundary signs 5 ft. South and 5 ft. East from corner.
 Nailed bearing tree signs and brass washers stamped PLS 848 to trees.
 Painted red band around each tree.

Work Done By D.M. Ferguson Title Surveyor Date 7/31/81 State Registration No. or Agency OR PLS 848

Certified Copy Being Prepared? Yes No Filed At: Umatilla Co. Surveyor Off Date _____

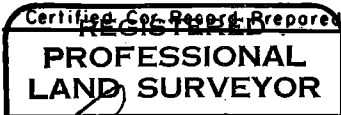

REMARKS

Witnesses to above corner:

D. Mitchell Ferguson

Mike Woodward

Index File No. _____

T.

R.

M.

Tract or Surv. No. _____

Cor. _____

12

13