

Index  
File No. L-5

## CORNER RECORD (SEARCH)

(Ref. FSM 7151.4)

Tract or  
Survey No. \_\_\_\_\_ No. \_\_\_\_\_T 45 R. 30ER.D. Ukiah County UmatillaMerid. WillametteN.F. Umatilla State Oregon

## CORNER DIAGRAM

T45 R30E

1/4

S 18' S 17'

1981

PLS 848



## DESCRIBE CORNER MONUMENT FOUND

Original stone not found.

## DESCRIBE BEARING TREES OR OTHER OFFICIAL ACCESSORIES FOUND

Found remains of 10 in. pine with 1949 location poster and blaze with small US stamped in blaze. Growth rings indicate this tree was blazed about 1949. Due to logging in area, no evidence found; therefore, set corner position by proportion.

## PHOTO IDENTIFICATION DATA

Photo No. \_\_\_\_\_

Filed At: \_\_\_\_\_

Object Ident. \_\_\_\_\_

Ident. By \_\_\_\_\_

*Signature*

## PLANE COORDINATE POSITION DATA

State \_\_\_\_\_ Zone \_\_\_\_\_

X \_\_\_\_\_

Y \_\_\_\_\_

Estab. By \_\_\_\_\_

*Agency*

## DESCRIBE CORNER LOCATION RELATIVE TO NEAR-BY FEATURES, ALSO HOW TO REACH CORNER

Corner is on a North slope approx. 100 ft. South from draw bottom in fir and pine timber.

*Signature*Title  
PLS 848

Division

Headquarters  
Mt. Vernon, OR

Date

9/19/81

7100-52-(3/68)

5

## CORNER RECORD (PERPETUATION)

## MONUMENT: DESCRIBE NEW MONUMENT SET, OR WORK DONE TO PRESERVE EXISTING MONUMENT

Set 3"x30" galv. iron pipe with 3" brass cap, stamped as shown on the diagram, set 20 inches in the ground.

From which:

## ACCESSORIES: DESCRIBE NEW BT'S WITNESS OBJECTS ETC. ESTABLISHED, OR WORK DONE TO PRESERVE EXISTING EVIDENCE

A fir 16 in. dia. bears N18°E, 9.4 ft. scribed 1/4 S 17 BT.

A fir 20 in. dia. bears S52°W, 6.3 ft. scribed 1/4 S 18 BT.

Set steel posts with warning and boundary signs 5 ft. East and 5 ft. South from corner.

Nailed bearing tree signs and brass washers stamped PLS 848 to each tree.  
Painted red band around each tree.

Work Done By D. M. Ferguson Title Surveyor Date 9/19/81 State Registration No. OR PLS 848  
or Agency

Certified  Registered  Expired? Yes  No  Filed At Umatilla Co. Surveyor's Office Date

**PROFESSIONAL  
LAND SURVEYOR**

REMARKS

Witnesses to above corner:

D. Mitchell Ferguson  
Mike Woodward

OREGON  
JULY 12, 1968  
DOUGLAS M. FERGUSON  
848

Index  
File No. L-5

T 4S R. 30E


Merid. Willamette

**CORNER RECORD (SEARCH)**  
(Ref. FSM 7151.4)

Tract or Survey No. 4-157 Cor. No. L-5

R.D. Ukiah County Umatilla  
N.F. Umatilla State Oregon

**CORNER DIAGRAM**

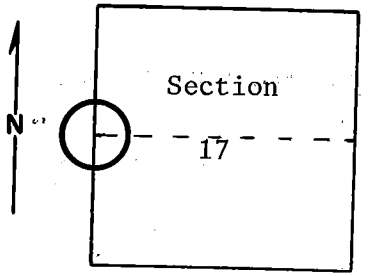

**DESCRIBE CORNER MONUMENT FOUND**

Material: None.  
Could find no evidence of stone.

**DESCRIBE BEARING TREES OR OTHER OFFICIAL ACCESSORIES FOUND**

The two original B.T.'s were pine. Nearly all the mature pine in the area has been logged and the stumps are rotted, or the trees have fallen and rotted.

**PHOTO IDENTIFICATION DATA**

Photo No. \_\_\_\_\_  
Filed At. \_\_\_\_\_  
Object Ident. \_\_\_\_\_  
Ident. By \_\_\_\_\_  
*Signature*

**DESCRIBE CORNER LOCATION RELATIVE TO NEAR-BY FEATURES, ALSO HOW TO REACH CORNER**

**PLANE COORDINATE POSITION DATA**

State \_\_\_\_\_ Zone \_\_\_\_\_  
X \_\_\_\_\_  
Y \_\_\_\_\_  
Estab. By \_\_\_\_\_  
*Agency*

Signature T. Hollamon Title Engineering Technician Division \_\_\_\_\_ Headquarters S. O. Date June 21, 1974

2

**CORNER RECORD (PERPETUATION)**

**MONUMENT : DESCRIBE NEW MONUMENT SET, OR WORK DONE TO PRESERVE EXISTING MONUMENT**

9

**ACCESSORIES : DESCRIBE NEW BT'S WITNESS OBJECTS ETC. ESTABLISHED, OR WORK DONE TO PRESERVE EXISTING EVIDENCE.**

10

Work Done By \_\_\_\_\_ Title \_\_\_\_\_ Date \_\_\_\_\_ State Registration No.  
or Agency \_\_\_\_\_

Certified Cor. Record Prepared ? Yes No Filed At: \_\_\_\_\_ Date \_\_\_\_\_

**REMARKS**

12

13

Index File No. T. R. M. Tract or Surv. No. Cor.