


Index
File No. N-7
T 4 S. R. 30 E.
Merid. Willamette

CORNER RECORD (SEARCH)
(Ref. FSM 7151.4)

Tract or
Survey No. _____
Cor. No. _____

R.D. Ukiah County Umatilla
N.F. Umatilla State Oregon

CORNER DIAGRAM

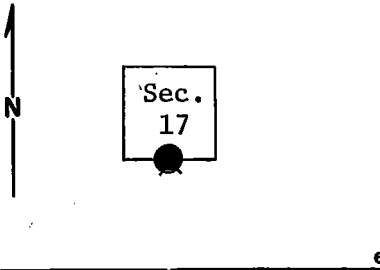

DESCRIBE CORNER MONUMENT FOUND

Basalt stone, 14"x8"x6", 6" above ground, in fair condition.
Can see no marks. If this is the original stone, it is no longer in original position as described in GLO Notes.

Monumented By BLM, 1978

DESCRIBE BEARING TREES OR OTHER OFFICIAL ACCESSORIES FOUND

A 40" ponderosa pine bears S.88°W., approx. 43 links. Blaze has been opened. Scribed 1/4 S. It has old location poster and orange paint.
A 20" ponderosa pine bears N.22°E., approx. 20 links. Has small closed scar. Scar does not face assumed corner; however, its size and location fits GLO. Has old location poster and orange paint.
(Cont. in Block 12)

PHOTO IDENTIFICATION DATA

Photo No. _____
Filed At. _____
Object Ident. _____
Ident. By _____
Signature

DESCRIBE CORNER LOCATION RELATIVE TO NEAR-BY FEATURES, ALSO HOW TO REACH CORNER

Approx. 150' SW of road. Use Sugarbowl Creek 7.5 minute quad. map to locate.

PLANE COORDINATE POSITION DATA

State _____ Zone _____
X _____
Y _____
Estob. By _____
Agency

Signature	Title	Division	Headquarters	Date	7100-52-(3/68)
T, Hollamon	Eng. Tech.		S.O.	4/12/74	

CORNER RECORD (PERPETUATION)

MONUMENT : DESCRIBE NEW MONUMENT SET, OR WORK DONE TO PRESERVE EXISTING MONUMENT

ACCESSORIES : DESCRIBE NEW BT's WITNESS OBJECTS ETC. ESTABLISHED, OR WORK DONE TO PRESERVE EXISTING EVIDENCE

I placed blank B.T. tag on each B.T.

Work Done By _____ Title _____ Date _____ State Registration No. or Agency _____

Certified Cor. Record Prepared ? Yes No Filed At _____ Date _____

REMARKS

There is a location poster and a sectionline marker board on a 10" ponderosa pine at road forks approximately 270' east.

Index File No. T. R. M. Tract or Surv. No. Cor.