

USDA-FOREST SERVICE

Index File No. P-22

T 4S R. 30E

Merid. Willamette

CORNER RECORD (SEARCH)

(Ref. FSM 7151.4)

R.D. Ukiah County Umatilla


N.F. Umatilla State Oregon

Tract or Survey No. \_\_\_\_\_ Cor. No. \_\_\_\_\_

12

CORNER DIAGRAM

T4S R30E

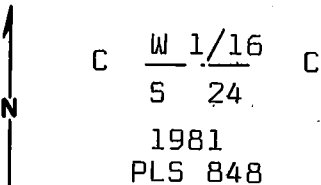

DESCRIBE CORNER MONUMENT FOUND

Corner not previously established.

DESCRIBE BEARING TREES OR OTHER OFFICIAL ACCESSORIES FOUND

N/A

PHOTO IDENTIFICATION DATA

Photo No. \_\_\_\_\_

Filed At. \_\_\_\_\_

Object Ident. \_\_\_\_\_

Ident. By \_\_\_\_\_

*Signature*

PLANE COORDINATE POSITION DATA

State \_\_\_\_\_ Zone \_\_\_\_\_

X \_\_\_\_\_

Y \_\_\_\_\_

Estab. By \_\_\_\_\_

*Agency*

*Signature*

Title

PLS 848

Division

Headquarters

Mt. Vernon, OR 7/2/81

Date

7100-52-(3/68)

6

7

8

2

3

4

5

CORNER RECORD (PERPETUATION)

MONUMENT: DESCRIBE NEW MONUMENT SET, OR WORK DONE TO PRESERVE EXISTING MONUMENT

Set 3"x30" galv. iron pipe with 3" brass cap stamped as shown on the diagram, set 10 in. in the ground and raised a mound of stone around the pipe.

From which:

ACCESSORIES : DESCRIBE NEW BT'S WITNESS OBJECTS ETC. ESTABLISHED, OR WORK DONE TO PRESERVE EXISTING EVIDENCE

A pine 10 in. dia. bears N43°W, 24.1 ft. scribed CW 1/16 S 24 BT.  
A pine 10 in. dia. bears S12°E, 26.2 ft. scribed CW 1/16 S 24 BT.  
Set steel posts with warning and boundary signs, 5 ft. West and 5 ft. South from corner. Nailed bearing tree signs and brass washers stamped PLS 848 to each tree.  
Painted red band around each tree.

Work Done By D.M. Ferguson Title Surveyor Date 7/2/81 State Registration No. OR PLS 848  
or Agency

Certified ~~REGISTERED~~ Prepared? Yes  No  Filed At: Umatilla Co. Surv. Office Date 10/81

**REGISTERED**  
**PROFESSIONAL**  
**LAND SURVEYOR**

REMARKS

Witnesses to above corner:  
D. Mitchell Ferguson  
Dave Herburger

*Douglas M. Ferguson*  
**OREGON**  
**JULY 12, 1968**  
**DOUGLAS M. FERGUSON**  
**848**