

Index
File No. Q-25

CORNER RECORD (SEARCH)
(Ref. FSM 7151.4)


Tract or Survey No. _____ Cor. No. _____

T 45 R. 30E

R.D. Ukiah County Umatilla

Merid. Willamette

N.F. Umatilla State Oregon

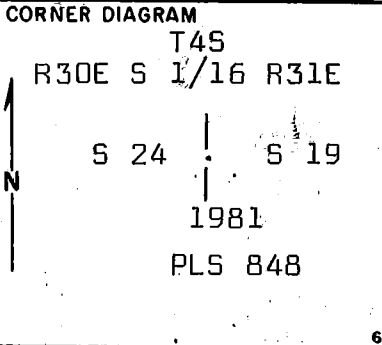

DESCRIBE CORNER MONUMENT FOUND

Corner not previously established.

DESCRIBE BEARING TREES OR OTHER OFFICIAL ACCESSORIES FOUND

N/A

PHOTO IDENTIFICATION DATA

Photo No. _____
Filed At. _____
Object Ident. _____
Ident. By _____
Signature

DESCRIBE CORNER LOCATION RELATIVE TO NEAR-BY FEATURES, ALSO HOW TO REACH CORNER

Corner on top of flat ridge. A N and E fence corner approx. 100 ft. N.W. from corner.
Corner in open ground.

PLANE COORDINATE POSITION DATA

State _____ Zone _____
X _____
Y _____
Estab. By _____
Agency

Signature Title PLS 848 Division _____ Headquarters Mt. Vernon, OR Date 8/13/81 7100-52-(3-68)

CORNER RECORD (PERPETUATION)

MONUMENT: DESCRIBE NEW MONUMENT SET, OR WORK DONE TO PRESERVE EXISTING MONUMENT

Set 3"x30" galv iron pipe with 3" brass cap stamped as shown on the diagram. Set pipe 8 inches in ground and raised a mound of stone around pipe.

From which:


ACCESSORIES: DESCRIBE NEW BT'S WITNESS OBJECTS ETC. ESTABLISHED, OR WORK DONE TO PRESERVE EXISTING EVIDENCE

A pine 16 inches dia. bears S27°E, 60.6 ft. scribed S 1/16 S 19 BT.
A pine 16 inches dia. bears S38°W, 61.5 ft. scribed S 1/16 S 24 BT.
Set steel posts with warning and boundary signs 5 ft. North and 5 ft. West from corner.
Nailed bearing tree signs and brass washers stamped PLS 848 to each tree.
Painted red band around each tree.

Work Done By: D.M. Ferguson title Surveyor Date 8/13/81 State Registration No. or Agency OR PLS 848

Certified Cor Record Prepared? Yes No Filed At: Umatilla Co. Surveyor Date

REGISTERED
PROFESSIONAL
LAND SURVEYOR

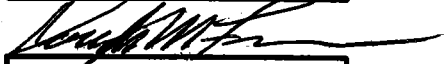

OREGON
JULY 12, 1968
DOUGLAS M. FERGUSON
848

REMARKS

Witnesses to above corner:

D. Mitchell Ferguson
Mike Woodward