

Index
File No. R-19

CORNER RECORD (SEARCH)
(Ref. FSM 7151.4)

Tract or
Survey No. 4-148 Cor.
No. R-19


T 4S R. 30E

R.D. Ukiah County Umatilla

Merid. Willamette

N.F. Umatilla State Oregon

CORNER DIAGRAM

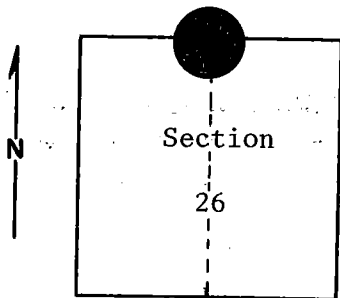

DESCRIBE CORNER MONUMENT FOUND

Material: None.

Monumented by BLM, 1978 (R.M.'s)
No markings. Location falls exactly in bottom of stream bed.
Stream flows over it during run-off. There are many stones.

DESCRIBE BEARING TREES OR OTHER OFFICIAL ACCESSORIES FOUND

A 24-inch p.pine bears N34°W, 14 feet. Scribed ¼ S, B.T. It has an old location poster and an old "Attention" poster. It grows on edge of stream bank.

An 18-inch p.pine, down and rotting, bears S44°W, approximately 20 feet. Scribed ¼ S, B.T. Its up-root lies at south edge of stream bed.

DESCRIBE CORNER LOCATION RELATIVE TO NEAR-BY FEATURES, ALSO HOW TO REACH CORNER

The stream, in which ¼ corner lies, flows nearly due east. A primitive road crosses this stream approximately 400 feet east.

PHOTO IDENTIFICATION DATA

Photo No. _____
Filed At. _____
Object Ident. _____
Ident. By _____
Signature

PLANE COORDINATE POSITION DATA

State _____ Zone _____
X _____
Y _____
Estab. By _____
Agency

Signature T. Hollamon Title Engineering Technician Division S. O. Headquarters S. O. Date June 10, 1974

7100-52-(3/68)

CORNER RECORD (PERPETUATION)

MONUMENT: DESCRIBE NEW MONUMENT SET, OR WORK DONE TO PRESERVE EXISTING MONUMENT

9

ACCESSORIES : DESCRIBE NEW BT'S WITNESS OBJECTS ETC. ESTABLISHED, OR WORK DONE TO PRESERVE EXISTING EVIDENCE

I placed blank B.T. tags on the two B.T.'s.

I also placed a location poster on a 50-inch white fir at east edge of road approximately 400 feet east of 1/4 corner (where road crosses stream).

10

Work Done By _____ Title _____ Date _____ State Registration No. or Agency _____

Certified Cor. Record Prepared ? Yes No Filed At: _____ Date _____

11

REMARKS

12

Index File No. T. R. M. Tract or Surv. No. Cor.

13