

USDA-FOREST SERVICE

Index File No. R-22

CORNER RECORD (SEARCH)

(Ref. FSM 7151.4)

Tract or Survey No. _____ No. _____


T 4 S R. 30E

R.D. Ukiah County Umatilla

Merid. Willamette

N.F. Umatilla State Oregon

CORNER DIAGRAM

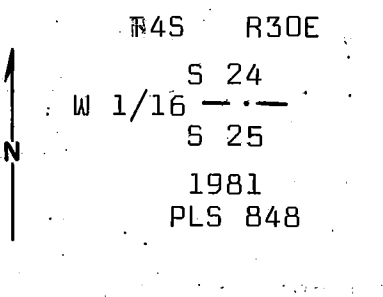

DESCRIBE CORNER MONUMENT FOUND

Corner not previously established.

DESCRIBE BEARING TREES OR OTHER OFFICIAL ACCESSORIES FOUND

N/A

PHOTO IDENTIFICATION DATA

Photo No. _____
Filed At _____
Object Ident. _____
Ident. By _____
Signature

DESCRIBE CORNER LOCATION RELATIVE TO NEAR-BY FEATURES, ALSO HOW TO REACH CORNER

Corner is on the top of wide open ridge approximately 250 ft. South of ridge road.

PLANE COORDINATE POSITION DATA

State _____ Zone _____
X _____
Y _____
Estab. By _____
Agency

Signature _____ Title _____ Division _____ Headquarters _____ Date _____

PLS 848 Mt. Vernon, OR 7/2/81 7100-52-(3/68)

CORNER RECORD (PERPETUATION)

MONUMENT: DESCRIBE NEW MONUMENT SET, OR WORK DONE TO PRESERVE EXISTING MONUMENT

Set 3"x30" galv. iron pipe with 3" brass cap stamped as shown on the diagram, set 6 in. in the ground and raised a mound of stone around pipe.

9

ACCESSORIES : DESCRIBE NEW BT'S WITNESS OBJECTS ETC. ESTABLISHED, OR WORK DONE TO PRESERVE EXISTING EVIDENCE

No bearing trees available.

Set steel posts with warning and boundary signs 5 ft. North and 5 ft. West from corner.

10

Work Done By D. M. Ferguson Title Surveyor Date 7/2/81 State Registration No. OR PLS 848
or Agency

Certified Copy Record Prepared? Yes No Filed At Umatilla Co. Surveyor Off. Date

11

**PROFESSIONAL
LAND SURVEYOR**

REMARKS

Witnesses to above corner:

OREGON
JULY 12, 1968
DOUGLAS M. FERGUSON
848

D. Mitchell Ferguson

Dave Herburger

12

Index File No.

T.

R.

M.

Tract or Surv. No.

Cor.

13