


Index No. J-23
 49° R. 30E
 Merid. Willamette

CORNER RECORD (SEARCH)
 (Ref. FSM 7151.4)

Tract or Survey No. _____
 Cor. No. _____

R.D. Ukiah County Umatilla
 N.F. Umatilla State Oregon

CORNER DIAGRAM

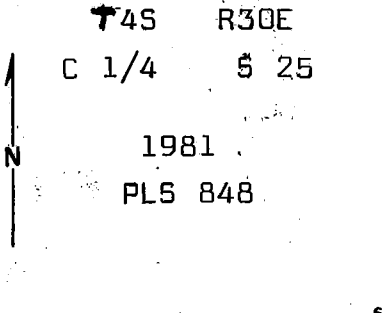

DESCRIBE CORNER MONUMENT FOUND

Corner not previously established.

DESCRIBE BEARING TREES OR OTHER OFFICIAL ACCESSORIES FOUND

N/A

PHOTO IDENTIFICATION DATA

Photo No. _____
 Filed At. _____
 Object Ident. _____
 Ident. By _____
 Signature _____

PLANE COORDINATE POSITION DATA

State _____ Zone _____
 X _____
 Y _____
 Estab. By _____
 Agency _____

DESCRIBE CORNER LOCATION RELATIVE TO NEAR-BY FEATURES, ALSO HOW TO REACH CORNER

Corner on a South slope in open timber approx. 40 ft. uphill, North from E-W road. A N-S fence approx. 200 ft. East from corner. Corner can be seen from road.

Signature

Title PLS 848 Division _____ Headquarters Mt. Vernon, OR Date 8/13/81
 7100-52-(3-68)

CORNER RECORD (PERPETUATION)

MONUMENT: DESCRIBE NEW MONUMENT SET, OR WORK DONE TO PRESERVE EXISTING MONUMENT

Set 3"x30" galv. iron pipe with 3" brass cap stamped as shown on the diagram; set 24 inches in the ground.

From which:

ACCESSORIES : DESCRIBE NEW BT'S WITNESS OBJECTS ETC. ESTABLISHED, OR WORK DONE TO PRESERVE EXISTING EVIDENCE

A pine 13 inches dia. bears N13°W, 19.4 ft. scribed C 1/4 S 25 BT.
 A pine 14 inches dia. bears S27°E, 62.9 ft. scribed C 1/4 S 25 BT.
 Set steel posts with warning and boundary signs 5 ft. West and 5 ft. North from corner.
 Nailed bearing tree signs and brass washers stamped PLS 848 to each tree.
 Painted red band around each tree.

Work Done By D.M. Ferguson Title Surveyor Date 8/13/81 State Registration No. OR PLS 848
 or Agency

Certified Correctly Prepared Yes No Filed At: Umatilla Co. Surveyor Off Date

**REGISTERED
PROFESSIONAL
LAND SURVEYOR**

REMARKS

Witnesses to above corner:
 D. Mitchell Ferguson
 Mike Woodward

OREGON
 JULY 12, 1968
 DOUGLAS M. FERGUSON
 848