

USDA-FOREST SERVICE


Index  
File No. A-21  
T 4S R. 31E  
Merid. Willamette

CORNER RECORD (SEARCH)

(Ref. FSM 7151.4)

R.D. Ukiah County Umatilla Tract or Survey No. Sec 2 Cor. No. NE  
N.F. Umatilla State Oregon

CORNER DIAGRAM

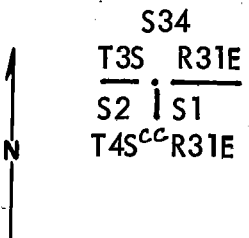

DESCRIBE CORNER MONUMENT FOUND

15" x 12" x 7" stone in mound of stone.

DESCRIBE BEARING TREES OR OTHER OFFICIAL ACCESSORIES FOUND

A 32" dia Pine Stump bears S23 1/2° E 62.4 ft dist - (old BT, visible scribing "BT").

PHOTO IDENTIFICATION DATA

Photo No. 616140 380-3  
Filed At. Umatilla Nat. Forest  
Object Ident. Trees  
Ident. By \_\_\_\_\_  
*Signature*

PLANE COORDINATE POSITION DATA

State \_\_\_\_\_ Zone \_\_\_\_\_  
X \_\_\_\_\_  
Y \_\_\_\_\_  
Estab. By \_\_\_\_\_  
*Agency*

DESCRIBE CORNER LOCATION RELATIVE TO NEAR-BY FEATURES, ALSO HOW TO REACH CORNER

Road #5420 to road #5412-100, West on #5412-100 approx. 1.4 miles to road fork South through gate, then along road to West turning Southeast across meadow 0.5 mile from gate, then road forks back to East along South edge of meadow for approx. 1,000 ft, then South approx. 750 ft to corner in timber on very slight South slope, 200 ft West of drainage.

Signature  
*William R. Wells*

Title  
PLS 1106

Division

Headquarters

Date

October 20, 1982

7100-52-(3,68)

**CORNER RECORD (PERPETUATION)**

**MONUMENT : DESCRIBE NEW MONUMENT SET, OR WORK DONE TO PRESERVE EXISTING MONUMENT**

Set 2 1/2" brass cap on 2 1/2" x 30" l. pipe 23" in ground with mound of stone.

Set steel fence post with 54-2 & 4 signs attached East of corner. Cap marked:

S34  
T3S R31E  
 S2 | S1  
T4S R31E  
 1982  
 PLS 1106

**ACCESSORIES : DESCRIBE NEW BT'S WITNESS OBJECTS ETC. ESTABLISHED, OR WORK DONE TO PRESERVE EXISTING EVIDENCE**

A 11" dia Pond. Pine bears S23 $\frac{1}{2}$ °E 44.0 ft dist marked: T4S R31E S1 BT.

A 14" dia Pond. Pine bears S51°W 52.4 ft dist marked: T4S R31E S2 BT.

Blaze faces and 6" bands around bearing trees are painted red. Tagged trees with 54-3 & 4 signs.

New BTs have a lower blaze, scribed BT, with brass washer stamped PLS 1106 nailed flush.

Work Done By. W.R. Wells Title Surveyor Date 10/20/82 State Registration No. PLS 1106  
 or Agency

Certified Cor. Record Prepared? Yes  No  Filed At: Umatilla County Surveyor Office Date \_\_\_\_\_

**REMARKS**

Witnessed by: Leslie E. Wilson

Index File No. A-21

**CORNER RECORD (SEARCH)**

Tract-or Survey No. S-43 Cor. No. A-21


T 4S R. 31E

R.D. Ukiah County Umatilla

Merid. Willamette

N.F. Umatilla State Oregon

**CORNER DIAGRAM**

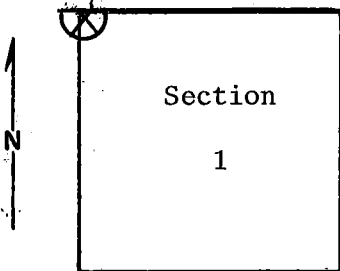

**DESCRIBE CORNER MONUMENT FOUND**

Material: Basalt stone. Size: 16" x 10" x 5".  
Ten inches above ground; good condition. Cannot distinguish marking. Sets in 24-inch diameter stone mound.

2

**DESCRIBE BEARING TREES OR OTHER OFFICIAL ACCESSORIES FOUND**

A 40-inch p. pine stump bears S 25°E, approximately 60 feet.  
Found "B.T." scribed by opening stump.  
A 20-inch p. pine stump is in approximately the proper location for SW B.T., but is too rotten to find scribing.  
An 8-inch p. pine with 1951 F.S. location poster bears NE, approximately 5 feet.

3

**DESCRIBE CORNER LOCATION RELATIVE TO NEAR-BY FEATURES, ALSO HOW TO REACH CORNER**

Found by compass and by pacing from other corners along township line.

**PHOTO IDENTIFICATION DATA**

Photo No. \_\_\_\_\_  
Filed At. \_\_\_\_\_  
Object Ident. \_\_\_\_\_  
Ident. By \_\_\_\_\_  
*Signature*

6

7

**PLANE COORDINATE POSITION DATA**

State \_\_\_\_\_ Zone \_\_\_\_\_  
X \_\_\_\_\_  
Y \_\_\_\_\_  
Estab. By \_\_\_\_\_  
*Agency*

8

4

Signature: T, Hollamon Title: Engineering Technician Division: \_\_\_\_\_ Headquarters: S, O. Date: November 7, 1974 7100-52  
REV. 65 5

CORNER RECORD (PERPETUATION)

MONUMENT: DESCRIBE NEW MONUMENT SET, OR WORK DONE TO PRESERVE EXISTING MONUMENT

9

ACCESSORIES : DESCRIBE NEW BT'S WITNESS OBJECTS ETC. ESTABLISHED, OR WORK DONE TO PRESERVE EXISTING EVIDENCE

I placed blank B.T. tags on stump in SE quadrant. I tied red and white striped ribbon on B.T. stump and in the vicinity of corner stone.

10

Work Done By \_\_\_\_\_ Title \_\_\_\_\_ Date \_\_\_\_\_ State Registration No. or Agency \_\_\_\_\_

Certified Cor. Record Prepared ? Yes No Filed At: \_\_\_\_\_ Date \_\_\_\_\_

11

REMARKS

12

Index File No. T. R. M. Tract or Surv. No. Cor, 13