


Index  
 File No. N-25 **CORNER RECORD (SEARCH)** Tract or Survey No. \_\_\_\_\_ Cor. No. \_\_\_\_\_  
 (Ref. FSM 7151.4)  
 T 4 S. R. 30 E. R.D. Ukiah County Umatilla  
 Merid. Willamette N.F. Umatilla State Oregon

CORNER DIAGRAM

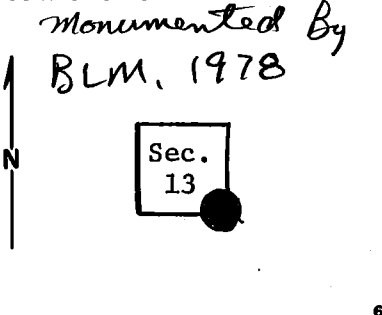

DESCRIBE CORNER MONUMENT FOUND

Basalt stone, 16"x12"x9", 10" above ground, good condition. No markings. None mentioned in the original notes.

DESCRIBE BEARING TREES OR OTHER OFFICIAL ACCESSORIES FOUND

A 30" p.pine snag stump (tree down-broken off) bears N.59°E., approx. 35 ft. Probably scribed on side next to ground. Down tree has an old "Witness Tree" board. A 20" p.pine bears S.52°E., approx. 40'. Scribing visible. It also has old "Witness Tree" board, wording barely legible. A down and rotting p.pine which was probably 26" bears S.44°W., approx. 50 ft. Scribing barely (cont. in block 12)

PHOTO IDENTIFICATION DATA

Photo No. \_\_\_\_\_  
 Filed At. \_\_\_\_\_  
 Object Ident. \_\_\_\_\_  
 Ident. By \_\_\_\_\_  
*Signature*

DESCRIBE CORNER LOCATION RELATIVE TO NEAR-BY FEATURES, ALSO HOW TO REACH CORNER

Corner is approx. 400 ft. north of old road which parallels Cooper Creek (on the north side).

PLANE COORDINATE POSITION DATA

State \_\_\_\_\_ Zone \_\_\_\_\_  
 X \_\_\_\_\_  
 Y \_\_\_\_\_  
 Estab. By \_\_\_\_\_  
*Agency*

Signature T. Hollamon Title Eng, Tech, Division \_\_\_\_\_ Headquarters S,O, Date 5/17/74 7100-52-(3/68)

CORNER RECORD (PERPETUATION)

MONUMENT: DESCRIBE NEW MONUMENT SET, OR WORK DONE TO PRESERVE EXISTING MONUMENT

ACCESSORIES : DESCRIBE NEW BT'S WITNESS OBJECTS ETC. ESTABLISHED, OR WORK DONE TO PRESERVE EXISTING EVIDENCE

I placed blank B.T. tags on all 4 B.T.'s.

Work Done By \_\_\_\_\_ Title \_\_\_\_\_ Date \_\_\_\_\_ State Registration No. or Agency \_\_\_\_\_

Certified Cor. Record Prepared ? Yes No Filed At: \_\_\_\_\_ Date \_\_\_\_\_

REMARKS

(Cont. Block 3) visible. (GLO says S34<sup>OW</sup>., 78 links) A 20" p.pine bears N.58<sup>OW</sup>., approx. 50' Some scribing visible. Can read S13. It has an "Attention" (warning) poster (GLO says N68<sup>OW</sup>., 77 links). A 6" p.pine bears north (approx.) about 6 ft. It has a location poster and 2 "Area back of this sign is National Forest land" posters. One facing south, one facing east. Location poster on 27" p.p. approx. 430 ft. S. (between road and creek) 30' S. of road. Location poster on 30" p.p. approx. 700 ft. W (15' N. of road near mouth of south-flowing side drainage.)

Index File No. T. R. M. Tract or Surv. No. Cor. 13