

CERTIFIED RECORD OF LAND CORNER MONUMENTATION

N - 3  
DIAGRAM

**History of original corner establishment:**

The original corner was established by George S. Pershin on October 29, 1880, under GLO contract No. 373, as follows:

Set a basalt stone, 17" x 8" x 7", on an east slope for the 1/4 section corner for sections 18 and 19, from which:

- A 10" pine bears N73° E, 24 links (15.84 feet).
- A 10" pine bears S42° E, 40 links (26.4 feet).

**Corner evidence recovered:**

Found the original corner stone solidly set in a mound of stones. The corner stone is 16" x 10" x 7" and is plainly marked "1/4" on the south face, from which:

- A live and vigorous 20" Ponderosa Pine with double healed blazes bears N74° E, 15.84 feet.
- A 23" broken Ponderosa Pine stump, with scribes "1/4S BT" visible on the log lying alongside, bears S40° E, 26.4 feet.

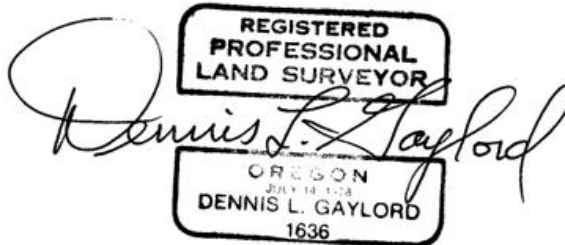
**Monument and accessories established to perpetuate the original position of this corner:**

In place of the original corner stone, I set a 1" x 30" galvanized iron pipe 16" into the ground to bed rock. A 2 1/2" brass cap attached to the top of the pipe is marked as shown in the diagram above. I bury the corner stone along the south side of the pipe and build a mound of stones around the pipe, from which:

- A 16" Ponderosa Pine scribed "1/4S19 BT" bears S10°E, 33.7 feet.
- A 14" Ponderosa Pine scribed "1/4S19 BT" bears S21° W, 43.8 feet.
- A 17" Ponderosa Pine scribed "1/4S18 BT" bears N46° 30'W, 81.2 feet.

The original living bearing tree has a Bearing Object sign nailed above the blazes. The three new bearing trees are scribed on double blazes, have a 3/4" brass washer marked "PLS 1636" nailed to the scribed "B", and have a Bearing Object sign nailed above the blazes. The new bearing tree to the southeast has a Witness Post sign nailed to the back side of the tree.

I hereby certify the above corner point was perpetuated as hereon described on June 8, 2001. Magnetic declination set in compass: 18° 30'E.

  
 REGISTERED  
 PROFESSIONAL  
 LAND SURVEYOR  
 OREGON  
 JULY 14, 1928  
 DENNIS L. GAYLORD  
 1636

Renews June 30, 2003

Recorded at the office of County Surveyor, County of Umatilla, State of Oregon, on \_\_\_\_\_, 2001

RECEIVED BY  
 Umatilla County Surveyor  
 Date 6-01  
 Rec'd By AK  
 No. D1-91-R