


Index File No. R-25 **CORNER RECORD (SEARCH)** (Ref. FSM 7151.4) Tract or Survey No. \_\_\_\_\_ Cor. No. \_\_\_\_\_  
 T 4 S. R. 30 E. R.D. Ukiah County Umatilla  
 Merid. Willamette N.F. Umatilla State Oregon

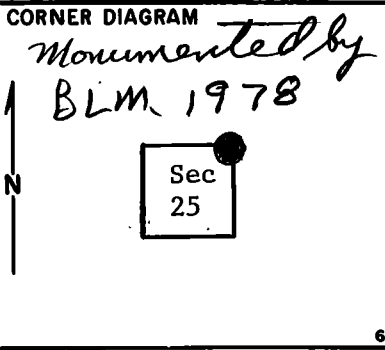

**DESCRIBE CORNER MONUMENT FOUND**

Basalt stone. Approx. size fits GLO.  
 No visible markings. Large stone in center of mound stands on end.

**DESCRIBE BEARING TREES OR OTHER OFFICIAL ACCESSORIES FOUND**

All 3 original B.T.'s still stand with visible scribing. The tree in the NE quadrant has been lightning struck and is dead. Scribing on it is very faint. This tree leans heavily to the south. All B.T.'s have B.T. tags. There is an aluminum BLM location poster on 12" p. pine 20 ft. west of corner.

**PHOTO IDENTIFICATION DATA**

Photo No. \_\_\_\_\_  
 Filed At. \_\_\_\_\_  
 Object Ident. \_\_\_\_\_  
 Ident. By \_\_\_\_\_  
*Signature*

**DESCRIBE CORNER LOCATION RELATIVE TO NEAR-BY FEATURES, ALSO HOW TO REACH CORNER**

Corner is on a NE slope at edge of timber. **A** primitive road ends approx. 200 ft. west.

**PLANE COORDINATE POSITION DATA**

State \_\_\_\_\_ Zone \_\_\_\_\_  
 X \_\_\_\_\_  
 Y \_\_\_\_\_  
 Estab. By \_\_\_\_\_  
*Agency*

Signature	Title	Division	Headquarters	Date	7100-52-(3/68)
T, Hollamon	Eng, Tech.		S.O.	5/10/74	

**CORNER RECORD (PERPETUATION)**

**MONUMENT: DESCRIBE NEW MONUMENT SET, OR WORK DONE TO PRESERVE EXISTING MONUMENT**

**ACCESSORIES : DESCRIBE NEW BT'S WITNESS OBJECTS ETC. ESTABLISHED, OR WORK DONE TO PRESERVE EXISTING EVIDENCE**

Work Done By \_\_\_\_\_ Title \_\_\_\_\_ Date \_\_\_\_\_ State Registration No. \_\_\_\_\_  
or Agency \_\_\_\_\_

Certified Cor. Record Prepared ? Yes No Filed At: \_\_\_\_\_ Date \_\_\_\_\_

**REMARKS**

Index File No. T. R. M. Tract or Surv. No. Cor.

9

10

11

12

13