

OREGON CORNER RESTORATION FORM

Section 21 Township 4S Range 31E
 County Umatilla Date: August 11, 2009

Corner Designation: 4S31R11


Quarter corner common to sections 21 and 28, T4S, R31E,
 W.M., Umatilla County, Oregon.

Condition Report Only
 Not found
 Remonumented
 Unrecorded
 Surveyed in
 Referenced out


Previous Renewals / Surveys, etc.

Corner originally set by George S. Pershin under contract No. 373 dated September 17, 1880. His record reads: Set basalt stone 18 x 12 x 12 on E. slope in mound of stone for 1/4 sec. cor.

Monument and Accessories found: (condition and source)
 None.

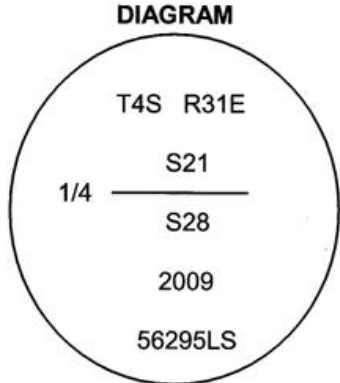

- = Brass cap
- = Rebar Reference
- = Guard Post w/sign

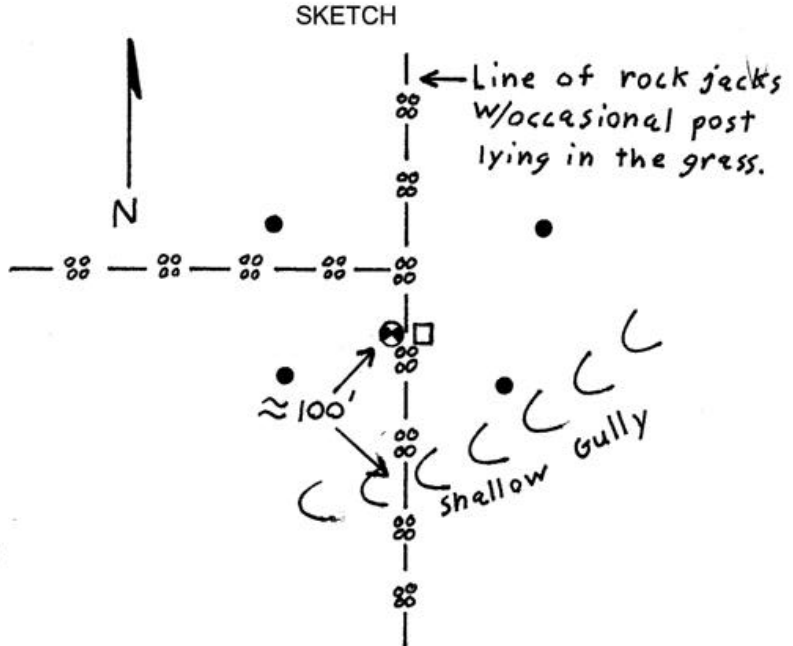

MONUMENT (S) AND ACCESSORIES SET (Procedures and Description)

At the proportionate point I set a 2 3/8" brass cap on a 1 1/2" x 30" galvanized iron pipe 26" in the ground. I built a collar of stone around the cap approximately 3' in diameter.

For references, I set four 5/8" by 24" rebars with 1.25" orange plastic caps stamped WTS and 56295LS as described below:

- an iron rebar bears N33°18'34"W, 42.90 feet;
- an iron rebar bears N56°14'18"E, 49.21 feet;
- an iron rebar bears S39°14'34"E, 40.54 feet;
- an iron rebar bears S43°14'59"W, 40.19 feet;

The monument and references were tied using a Trimble R7/R8 RTK GPS.

Location and comments

Witnessed By:
 Jacob Fitzgerald

RECEIVED BY:
 Umatilla County Surveyor
 Date: 9-09
 Rec'd By: KK
 No. 09-123-B

Compass Declination

Firm / Agency
 Witness Tree Surveying
 Address
 P.O. Box G
 Pilot Rock, Or. 97868
 Party Chief
 Stephen K, Haddock

Surveyors Seal

REGISTERED
 PROFESSIONAL
 LAND SURVEYOR

Stephen K. Haddock

OREGON
 JULY 9, 2001
 STEPHEN K. HADDOCK
 56295LS

RENEWAL DATE 6-30-11