

Index
File No. J-13


CORNER RECORD (SEARCH)

(Ref. FSM 7151.4)

Tract or Survey No. _____ Cor. No. _____

T 4 S R. 32 E R.D. Ukiah County Umatilla
Merid. Willamette N.F. Umatilla State Oregon

CORNER DIAGRAM

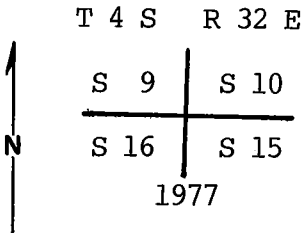

DESCRIBE CORNER MONUMENT FOUND

Found 2½" iron pipe with ¾" brass cap (as shown in corner diagram) no stones available.

DESCRIBE BEARING TREES OR OTHER OFFICIAL ACCESSORIES FOUND

- A 23" ponderosa pine brs S30°W, 31.1' with scribing visible.
- A 20" dead white fir brs S34 3/4°E, 41.5' with scribing visible.
- A 13" dead white fir brs N77 1/4°E, 38.6' with scribing visible.
- A 24" dead white fir brs N26°W, 34.6' with healed blaze.

PHOTO IDENTIFICATION DATA

Photo No. _____
Filed At. _____
Object Ident. _____
Ident. By _____
Signature _____

DESCRIBE CORNER LOCATION RELATIVE TO NEAR-BY FEATURES, ALSO HOW TO REACH CORNER

Corner falls on Northwesterly slope, timber newly logged, fence E & W, posted line South.

PLANE COORDINATE POSITION DATA

State _____ Zone _____
X _____
Y _____
Estab. By _____
Agency _____

Signature Walter R. Wells Title Land Surveyor Division _____ Headquarters Pendleton, Ore. Date 6-03-92 FS-7100-52 (3/68)

CORNER RECORD (PERPETUATION)

MONUMENT: DESCRIBE NEW MONUMENT SET, OR WORK DONE TO PRESERVE EXISTING MONUMENT

Set steel fence post next to corner with sign 54-9 & 54-2 attached.
Compass declination 18° East.

ACCESSORIES : DESCRIBE NEW BT'S WITNESS OBJECTS ETC. ESTABLISHED, OR WORK DONE TO PRESERVE EXISTING EVIDENCE

New bearing trees established:

A 17" ponderosa pine brs N35 $\frac{1}{4}$ ° W, 32.1' scribed T4SR32ES9 BT.

A 13" western larch brs N41° E, 25.0' scribed T4SR32ES10 BT.

A 23" ponderosa pine brs S77 $\frac{1}{4}$ ° E, 94.5' scribed T4SR32ES15 BT.

New BT's have a brass washer stamped PLS 1106 nailed to face of blaze.
Attached sign 54-3 & 54-9, painted face of blaze & a 6" red band around each BT.

Work Done By W.R. Wells Title Land Surveyor Date 6-03-92 State Registration No. ORLS 1106
or Agency

Certified Cor. Record Prepared ? Yes XXX Filed At: Umatilla County Surveyor Date 7-92

REMARKS

Index File No. J-13

T. 4 S R. 32 E WM.

Tract or Surv. No.

Cor.

USDA-FOREST SERVICE


Index
File No. J-13
T 4S R. 32E
Merid. Willamette

CORNER RECORD (SEARCH)

(Ref. FSM 7151.4)

Tract or Survey No. Sec 9 1/10 Cor. No. See Cor
R.D. Ukiah County Umatilla
N.F. Umatilla State Oregon

CORNER DIAGRAM

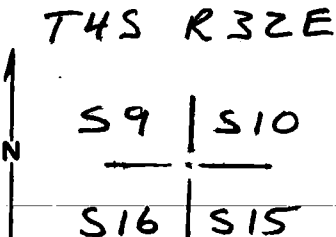

DESCRIBE CORNER MONUMENT FOUND

Found Standard BLM Monument
1977 EXP 4" MOS

DESCRIBE BEARING TREES OR OTHER OFFICIAL ACCESSORIES FOUND

G. Fir 14" dia., BRS N77°05'E 38.9 FT } OF WHICH WE HAVE NO REC.
G. Fir 24" dia., BRS S34°42'E 41.9 FT }
P. Pine 30" dia., BRS S2°16'W 30.4 FT (Rec S7°W 30.4 FT)
G. Fir 28" dia., BRS N26°17'W 34.3 FT (Rec N45°W 34.3 FT)

DESCRIBE CORNER LOCATION RELATIVE TO NEAR-BY FEATURES, ALSO HOW TO REACH CORNER

Go SOUTH ON Rd. 5417 1.5 mi TO Rd INTERSECTION
TAKE SOUTH FORK; Go 0.9 mi TO SOUTH LINE
SEC. 10; Go DUE WEST 2 mi TO SEC COR.

PHOTO IDENTIFICATION DATA

Photo No. _____
Filed At. _____
Object Ident. _____
Ident. By _____
Signature _____

PLANE COORDINATE POSITION DATA

State _____ Zone _____
X _____
Y _____
Estob. By _____
Agency _____

Signature Paul Weaver Title P.R.S. Division _____ Headquarters _____ Date 12/12/80
7100-52-(3,68)

CORNER RECORD (PERPETUATION)

MONUMENT: DESCRIBE NEW MONUMENT SET, OR WORK DONE TO PRESERVE EXISTING MONUMENT

ACCESSORIES : DESCRIBE NEW BT'S WITNESS OBJECTS ETC. ESTABLISHED, OR WORK DONE TO PRESERVE EXISTING EVIDENCE

Work Done By K.C. Weaver Title PLS Date 12/12/80 State Registration No. 1679
or Agency
Certified Cor. Record Prepared? Yes No Filed At: Date

REMARKS

Index File No. T. R. M. Tract or Surv. No. Cor.