

USDA-FOREST SERVICE

Index File No. J-14

CORNER RECORD (SEARCH)

(Ref. FSM 7151.4)

Tract or Survey No. Sec 10 Cor. No. W 1/16

T 4S R. 32


R.D. Ukiah County Umatilla

Merid. Willamette

N.F. Umatilla State Oregon

CORNER DIAGRAM

T4S R32E

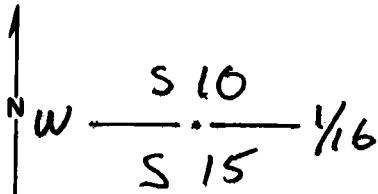

DESCRIBE CORNER MONUMENT FOUND

Found 2" G.I.P W/ 2 1/2" B.C. PLS 1051 1977
Exp. 12" M.O.S.

DESCRIBE BEARING TREES OR OTHER OFFICIAL ACCESSORIES FOUND

P. Pine 12" dia., Brs S17°23'W 48.3 FT

P. Pine 26" dia., Brs. N1°03'W 69.5 FT

PHOTO IDENTIFICATION DATA

Photo No. _____
Filed At. _____
Object Ident. _____
Ident. By _____
Signature _____

DESCRIBE CORNER LOCATION RELATIVE TO NEAR-BY FEATURES, ALSO HOW TO REACH CORNER

INTERSECTION 5412 AND 5417; SOUTH ON RD 5417
1.5 mi; TAKE SOUTH FORK 0.9 mi TO SOUTH LINE
SEC 10; GOE WEST 500' TO W 1/16

PLANE COORDINATE POSITION DATA

State _____ Zone _____
X _____
Y _____
Estab. By _____
Agency _____

Signature Kurt E Weaver

Title P.L.S.

Division _____

Headquarters _____

Date _____

12/12/80

7100-52-(3/68)

CORNER RECORD (PERPETUATION)

MONUMENT: DESCRIBE NEW MONUMENT SET, OR WORK DONE TO PRESERVE EXISTING MONUMENT

ACCESSORIES : DESCRIBE NEW BT's, WITNESS OBJECTS ETC. ESTABLISHED, OR WORK DONE TO PRESERVE EXISTING EVIDENCE

Work Done By KC Weaver Title PLS Date 12/12/00 State Registration No. 1679
or Agency

Certified Cor. Record Prepared ? Yes No Filed At: _____ Date _____

REMARKS

Index File No. T. R. M. Tract or Surv. No. Cor.

USDA-FOREST SERVICE


Index
File No. J-14
T 4S R. 32E
Merid. W.M.

CORNER RECORD (SEARCH)

(Ref. FSM 7151.4)
R.D. Ukiah County Umatilla
N.F. Umatilla State Oregon

Tract or
Survey No. _____
Cor. No. W1/16

CORNER DIAGRAM

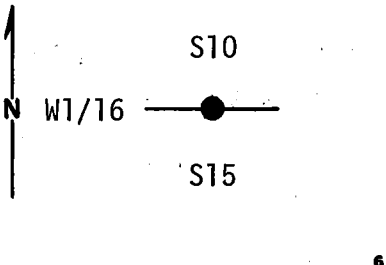

DESCRIBE CORNER MONUMENT FOUND

None Set.

DESCRIBE BEARING TREES OR OTHER OFFICIAL ACCESSORIES FOUND

None Set.

PHOTO IDENTIFICATION DATA

Photo No. _____
Filed At. _____
Object Ident. _____
Ident. By _____
Signature

DESCRIBE CORNER LOCATION RELATIVE TO NEAR-BY FEATURES, ALSO HOW TO REACH CORNER

The corner lies on a slight south slope about 100 feet south of an east-west fence.

PLANE COORDINATE POSITION DATA

State _____ Zone _____
X _____
Y _____
Estab. By _____
Agency

Barry B. Barber
Signature

Title P.L.S. Division _____ Headquarters _____ Date 10/31/77
7100-52-(3/68)

CORNER RECORD (PERPETUATION)

GPO 902-673

MONUMENT: DESCRIBE NEW MONUMENT SET, OR WORK DONE TO PRESERVE EXISTING MONUMENT

T4S R32E

S10

At surveyed point: Set 2½" x 30" galvanized pipe with brass cap marked:

W1/16 —+—

S15

1977

OR PLS 1051₉

ACCESSORIES: DESCRIBE NEW BT'S WITNESS OBJECTS ETC. ESTABLISHED, OR WORK DONE TO PRESERVE EXISTING EVIDENCE

From which a Pine 22" in dia. bears N10W, 69.5 feet, scribed W1/16 S10 BT.
 A Pine 8" in dia. bears S180W, 48.3 ft., scribed W1/16 S 15 BT.
 Set pipe 18" in ground and built a mound of stones to the cap. Attached 54-3 and 54-4 signs to both BT's. Attached a brass washer, stamped PLS 1051 to foot blaze of both BT's. Painted a 6" band and both blazes on each BT red. Set painted metal fence post 3 ft. north of corner with 54-2 and 54-4 signs attached. Set another metal fence post 3 ft. west of corner with 54-2 and 54-9 signs attached.

10

Work Done By R. C. Orton Title Party Chief Date 10/31/77 State Registration No. or Agency

Certified Cor. Record Prepared? Yes No Filed At: Date 11

REMARKS

Witnesses: G. Wagoner
 L. Clemens

12

Index File No. T. R. M. Tract or Surv. No. Cor. 13