

USDA-FOREST SERVICE

Index  
File No. L-19

CORNER RECORD (SEARCH)  
(Ref. FSM 7151.4)

Tract or  
Survey No. \_\_\_\_\_ Cor. No. C1/4

T 4S R. 32E


R.D. Ukiah County Umatilla

Merid. W.M.

N.F. Umatilla State Oregon

CORNER DIAGRAM

DESCRIBE CORNER MONUMENT FOUND

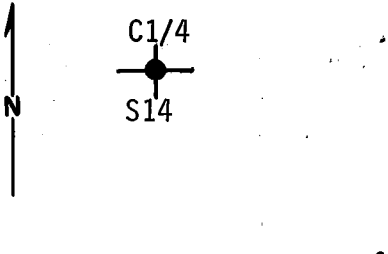

None set.

DESCRIBE BEARING TREES OR OTHER OFFICIAL ACCESSORIES FOUND

None set.

PHOTO IDENTIFICATION DATA

Photo No. \_\_\_\_\_  
Filed At. \_\_\_\_\_  
Object Ident. \_\_\_\_\_  
Ident. By \_\_\_\_\_  
*Signature*

DESCRIBE CORNER LOCATION RELATIVE TO NEAR-BY FEATURES, ALSO HOW TO REACH CORNER

PLANE COORDINATE POSITION DATA

State \_\_\_\_\_ Zone \_\_\_\_\_  
X \_\_\_\_\_  
Y \_\_\_\_\_  
Estab. By \_\_\_\_\_  
*Agency*

Corner falls about 250' west of fire road on nearly level ground. Dense growth of pine.

*Barney B. Barbour*  
*Signature*

Title P.L.S. Division \_\_\_\_\_ Headquarters \_\_\_\_\_ Date 10/25/77 7100-52-(3/68)

**CORNER RECORD (PERPETUATION)**

GPO 902-673

**MONUMENT: DESCRIBE NEW MONUMENT SET, OR WORK DONE TO PRESERVE EXISTING MONUMENT**

At surveyed point: Set 2½"x30" galvanized pipe with brass cap marked:  
Set pipe 16" in the ground to bedrock and mound of stone around rised to cap.

T 4S R32E  
Center 1/4  
+  
S14  
OR PLS 1051  
1977

**ACCESSORIES: DESCRIBE NEW BT'S WITNESS OBJECTS ETC. ESTABLISHED, OR WORK DONE TO PRESERVE EXISTING EVIDENCE**

From which a forked Pine 22" in diameter bears S30°E, 22.2 feet, scribed C1/4 S14 BT. A Pine 11" in diameter bears N55°W, 31.0 feet scribed C1/4 S14 BT. Placed 54-3 and 54-4 signs on both BT's. Placed brass washer stamped PLS 1051 on foot blazes. Painted 6" red band around BT's and both blazes red. Placed 54-4 and 54-9 on fence post 4 feet East of corner.

Work Done By B.B. Barbour Title P.L.S. Date 10/25/77 State Registration No. OR-PLS 1051  
or Agency

Certified Cor. Record Prepared? Yes  No  Filed At: \_\_\_\_\_ Date \_\_\_\_\_

**REMARKS**

Witnesses to the above corner: D.L. Landers  
S. Nelson