

USDA-FOREST SERVICE


Index  
 File No. ~~106~~ **M-6**  
 T 4S R. 32E  
 Merid. W.M.

CORNER RECORD (SEARCH)

(Ref. FSM 7151.4)  
 R.D. Ukiah County Umatilla  
 N.F. Umatilla State Oregon

Tract or Survey No. \_\_\_\_\_  
 Cor. No. SW1/16

CORNER DIAGRAM

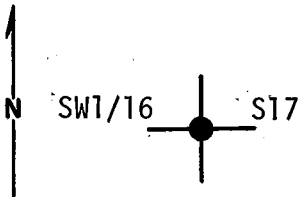

DESCRIBE CORNER MONUMENT FOUND

None set.

DESCRIBE BEARING TREES OR OTHER OFFICIAL ACCESSORIES FOUND

None set.

PHOTO IDENTIFICATION DATA

Photo No. \_\_\_\_\_  
 Filed At. \_\_\_\_\_  
 Object Ident. \_\_\_\_\_  
 Ident. By \_\_\_\_\_  
 Signature \_\_\_\_\_

DESCRIBE CORNER LOCATION RELATIVE TO NEAR-BY FEATURES, ALSO HOW TO REACH CORNER

Corner falls on a flat open bench.

PLANE COORDINATE POSITION DATA

State \_\_\_\_\_ Zone \_\_\_\_\_  
 X \_\_\_\_\_  
 Y \_\_\_\_\_  
 Estab. By \_\_\_\_\_  
 Agency \_\_\_\_\_

Signature *Barry B Barbour*


Title P.L.S. Division \_\_\_\_\_ Headquarters \_\_\_\_\_ Date 11/4/77 7100-52-(3/68)

**CORNER RECORD (PERPETUATION)**

GPO 902-673

**MONUMENT: DESCRIBE NEW MONUMENT SET, OR WORK DONE TO PRESERVE EXISTING MONUMENT**

Set 2½"x30" galvanized pipe 14" in the ground with mound of stone around to cap marked:

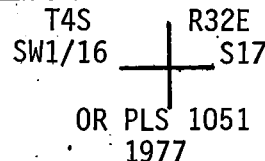

**ACCESSORIES: DESCRIBE NEW BT'S WITNESS OBJECTS ETC. ESTABLISHED, OR WORK DONE TO PRESERVE EXISTING EVIDENCE**

A pine 12" in dia. bears N68°W, 38.0' scribed SW1/16 S17 BT. A pine 9" in dia. bears S74°E, 39.6' scribed SW1/16 S17 BT. Placed 54-3's, and 54-4's and brass washer stamped PLS 1051 on BT blaze. Painted both blazes red and red band around BT's. Placed 54-2s, and 54-4s and 54-9s on fence posts 6' each and 3' north of corner.

Work Done By B.B. Barbour Title P.L.S. Date 11/4/77 State Registration No. or Agency OR PLS 1051

Certified Cor. Record Prepared? Yes  No  Filed At: \_\_\_\_\_ Date \_\_\_\_\_

**REMARKS**

Witnesses to the above: D.L. Landers, S. Nelson