

USDA FOREST SERVICE

CORNER RECORD (SEARCH)

Index

File No. T-22.25

R.D.: N.F.J.D.

Co. Survey No:

T.4S., R.32E.

N.F.: UMATILLA

County: Umatilla

Meridian: Willamette

CORNER DIAGRAM

DESCRIBE CORNER MONUMENT FOUND

S25

None. Corner established this survey.

C-W-E-W

1/256

1994

PLS 2405

DESCRIBE BEARING TREES OR OTHER OFFICIAL ACCESSORIES FOUND

None. Corner established this survey.

PHOTO ID DATA

Photo No.

Filed At

Object ID

PLANE CO-ORD

State Zone

X


Y

DESCRIBE CORNER LOCATION:

Estab.By

Corner falls on north slope of western larch, white fir,
and ponderosa pine.

Signature:

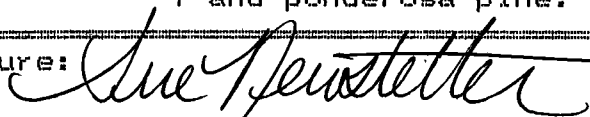

Title: Land Surveyor

Date: 10/25/94

CORNER RECORD (PERPETUATION)

MONUMENT: DESCRIBE NEW MONUMENT SET, OR WORK DONE TO PRESERVE EXISTING MON.
Set 2-1/2"x30" aluminum pipe with 3-1/2" aluminum cap, stamped as shown
on the DIAGRAM, 26" in the ground.

From Which:

ACCESSORIES: DESCRIBE NEW BT'S, W.O.'S ETC. ESTABL./WORK DONE TO PRESERVE
Western Larch, 10"dia., bears S86°39'E, 24.5 ft., scribed: C-W-E-W 1/256 S25 BT
Pond. Pine, 16"dia., bears S52°30'W, 10.2 ft., scribed: C-W-E-W 1/256 S25 BT
Measurements to BT's taken with an Electronic Tacheometer with bearings
based on the survey control network. Set steel fence post with Land Survey
Monument (54-9) and Property Boundary (54-2) signs 5' south and west of the
monument. Nailed a brass washer stamped PLS 2405 on blaze above BT scribe
as taken this survey. Nailed Bearing Tree (54-3) signs above blaze and
Land Survey Monument (54-9) signs on back of each tree as required.
Painted a 6" red band above Bearing Trees signs.

Work Done by: Susan E. Newstetter Dr. Land Surveyor No. 2405 Date: 10/25/94
Certified Cor. Record Prepared? Yes No Filed At: Umatilla Co. Survey.

REMARKS

Index File No. T-22.25 T.4S., R.32E., W.M.