

Index  
File No. R-13

**CORNER RECORD (SEARCH)**

(Ref. FSM 7151.4)

Tract or  
Survey No. \_\_\_\_\_ Cor.  
No. \_\_\_\_\_


T 4 S R. 32 E

R.D. Ukiah County Umatilla

Merid. Willamette

N.F. Umatilla State Oregon

**CORNER DIAGRAM**

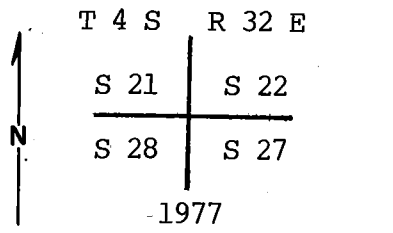

**DESCRIBE CORNER MONUMENT FOUND**

Found 2½" iron pipe with ¾" brass cap (as shown in corner diagram) in mound of stone.

**DESCRIBE BEARING TREES OR OTHER OFFICIAL ACCESSORIES FOUND**

- A 20" ponderosa pine brs N36° E, 111.9' with healed blaze.
  - A 27" ponderosa pine sawn stump about 7' high bears S80½° E, 97.0' with healed blaze.
  - A 26" ponderosa pine brs S19½° W, 129.4' with healed blaze.
  - A 22" ponderosa pine brs N20½° W, 44.9' with scribing visible.
- Decayed ponderosa pine root wad on ground brs N40° W, 7.8', no marks.

**PHOTO IDENTIFICATION DATA**

Photo No. \_\_\_\_\_  
 Filed At. \_\_\_\_\_  
 Object Ident. \_\_\_\_\_  
 Ident. By \_\_\_\_\_  
 Signature \_\_\_\_\_

**DESCRIBE CORNER LOCATION RELATIVE TO NEAR-BY FEATURES, ALSO HOW TO REACH CORNER**

Corner falls on Northwesterly slope, posted line E & W.

**PLANE COORDINATE POSITION DATA**

State \_\_\_\_\_ Zone \_\_\_\_\_  
 X \_\_\_\_\_  
 Y \_\_\_\_\_  
 Estab. By \_\_\_\_\_  
 Agency \_\_\_\_\_

Signature  
*Will R. Wells*

Title Land Surveyor Division \_\_\_\_\_ Headquarters Pendleton, Ore. Date 6-02-92

CORNER RECORD (PERPETUATION)

MONUMENT: DESCRIBE NEW MONUMENT SET, OR WORK DONE TO PRESERVE EXISTING MONUMENT

Set steel fence post next to corner with sign 54-9 & 54-2 attached.  
New BT ~~has~~ a brass washer stamped PLS 1106 nailed to face of blaze.  
Attached sign 54-3 & 54-9, painted face of blaze & a 6" red band  
around each BT.  
Compass declination 18° East.

9

ACCESSORIES : DESCRIBE NEW BT'S WITNESS OBJECTS ETC. ESTABLISHED, OR WORK DONE TO PRESERVE EXISTING EVIDENCE

New bearing tree established:  
A 17" ponderosa pine brs S9° E, 58.3' dist scribed T4SR32ES27 BT.

10

Work Done By W.R. Wells Title Land Surveyor Date 6-02-92 State Registration No. or Agency ORLS 1106  
Certified Cor. Record Prepared ? Yes  No  Filed Matilla County Surveyor Date 7-92

11

REMARKS

12

Index File No. R-13 T4 S R:32 E WM. Tract or Surv. No. Cor. 13