

CERTIFIED RECORD OF LAND CORNER MONUMENTATION


R-9

History of original corner establishment:

Corner originally established by George S. Pershin, U.S. Deputy Surveyor, under Contract No. 390, dated May 12, 1881.

Survey General records state:

Set basalt stone 20 x 12 x 5 in mound of stone on west slope for cor to Sec. 20, 21, 28 & 29 + 250.

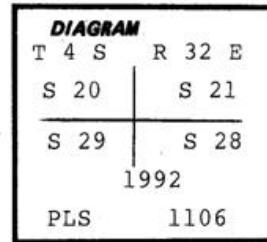

Description of corner evidence found:

Found a 5' ± dia. stone mound with old location poster in it. Found 2 stones of approximate record size but no visible marks. After surveying to found corners to the East & North, I accept the center of the stone mound as the best remaining evidence of the original corner location. There are also old down rail fences leading into the corner from the E & N. Mr. Frank Pedro, longtime property owner, also says the mound is the corner.

Description of monument and accessories I established to perpetuate the original location of this corner:


At center of stone mound, set a 2½" x 30" aluminum pipe with 2½" aluminum cap 20" in ground and surrounded with mound of earth and stone. Cap marked as shown in corner diagram. Set steel fence post East of corner with sign 54-2 & 54-9 attached.

There are no trees nearby, so I set 4 reference monuments...

- A 5/8" x 30" iron pin with 1½" aluminum cap bears N58½° E, 53.3' marked as shown at right...
- A 5/8" x 30" iron pin with 1½" aluminum cap bears S80° E, 64.3' marked as shown at right...
- A 5/8" x 30" iron pin with 1½" aluminum cap bears S36½° W, 54.4' marked as shown at right...
- A 5/8" x 30" iron pin with 1½" yellow plastic cap marked W.R. Wells, PLS 1106 bears N55½° W, 37.8'.

Compass declination 18° East.

I hereby certify that the above corner monument was properly re-monumented to U.S.F.S. standards by me on June 4, 1992.

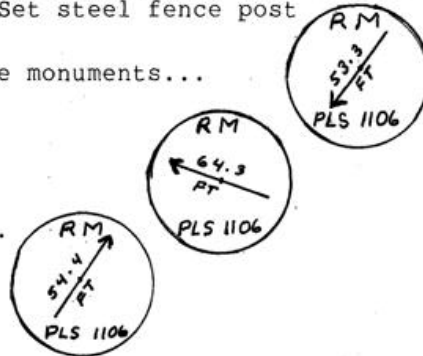

REGISTERED
PROFESSIONAL
LAND SURVEYOR

William R. Wells

OREGON
JULY 22, 1977
WILLIAM R. WELLS
1106

Office of..... County Surveyor..... County of..... Umatilla
State of..... Oregon....., I hereby certify that the within instrument was filed in this office
for record on the..... day of....., 19.....
..... by (DEPUTY)
(COUNTY OFFICIAL)

Form R6-7100-57 (9/71)

RECEIVED BY
Umatilla County Surveyor
Date 7-92
Rec'd By RE
No. 92-80-B

★ GPO—799-276

R-9