

USDA FOREST SERVICE

CORNER RECORD (SEARCH)

Index

File No. T-23

R.D.: N.F.J.D.

Co. Survey No:

T.4S., R.32E.

N.F.: UMATILLA

County: Umatilla

Meridian: Willamette

CORNER DIAGRAM

DESCRIBE CORNER MONUMENT FOUND

T4S R32E

C1/4

None. Corner established this survey

.

S25

1994

PLS 2405

DESCRIBE BEARING TREES OR OTHER OFFICIAL ACCESSORIES FOUND

None. Corner established this survey.

PHOTO ID DATA

Photo No.

Filed At

Object ID

PLANE CO-ORD

State Zone

X


Y

DESCRIBE CORNER LOCATION:

Estab.By

Corner falls on south slope of dead white fir and western larch. And old E-W road is 30 ft. south.

Signature:

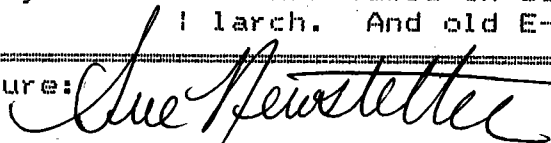

Title: Land Surveyor

Date: 10/24/94

CORNER RECORD (PERPETUATION)

MONUMENT: DESCRIBE NEW MONUMENT SET, OR WORK DONE TO PRESERVE EXISTING MON.
Set 2-1/2"x30" aluminum pipe with 3-1/2" aluminum cap, stamped as shown
on the DIAGRAM, 26" in the ground.

From Which:

ACCESSORIES: DESCRIBE NEW BT'S, W.O.'S ETC. ESTABL./WORK DONE TO PRESERVE
Lodgepole pine, 9" dia., bears N52°15'W, 36.9 ft., scribed: C1/4 S25 BT
Western Larch, 20" dia., bears S71°30'E, 72.7 ft., scribed: C1/4 S25 BT
5/8"x30" rebar, set 28" in ground, with yellow plastic cap marked PLS 2405
bears:

N38°30'E, 6.5 ft. (1 groove on rebar)

S37°45'W, 9.7 ft. (no groove on rebar)

Measurements to BT's and rebar taken with a magnetic compass, declination
20° East, and a nylon clad steel tape. Set steel fence post with Land
Survey Monument (54-9) and Property Boundary (54-2) signs 5' north and east
of the monument. Nailed a brass washer stamped PLS 2405 on blaze above BT
scribe as taken this survey. Nailed Bearing Tree (54-3) signs above blaze
and Land Survey Monument (54-9) signs on back of each tree as required.
Painted a 6" red band above Bearing Trees signs.

Work Done by: Susan E. Newstetter Dr. Land Surveyor No. 2405 Date: 10/24/94
Certified Cor. Record Prepared? Yes No Filed At: Umatilla Co. Survey.

REMARKS

Index File No. T-23

T.4S., R.32E., W.M.