

USDA FOREST SERVICE
Index
File No. V-15
T.46., R.32E.
Meridian: Willamette

CORNER RECORD (SEARCH)

R.D.: N.F.J.D.
N.F.: UMATILLA

Co. Survey No:
County: Umatilla

CORNER DIAGRAM | DESCRIBE CORNER MONUMENT FOUND
T46 R32E | Found iron monument pushed over after recent logging
S27 | operation.

1/4 _____
S34
1977

DESCRIBE BEARING TREES OR OTHER OFFICIAL ACCESSORIES FOUND

(BLM Cap)

PHOTO ID DATA | Ponderosa Pine stump, 26" dia., with healed blaze, bears
Photo No. | N46°38'E, 54.0 ft. (Orig. Rec: N47°E, 56.76 ft)


Filed At | Ponderosa Pine, 22" dia., with scribing visible, bears
Object ID | S22°35'W, 116.3 ft. (Orig. Rec: S23°W, 116.82 ft)

PLANE CO-ORD
State Zone

X
Y | DESCRIBE CORNER LOCATION:

Estab. By | Corner is approx. 10 ft. east of an old N-S road.

Signature:

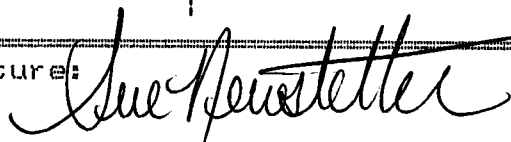

Title: Land Surveyor Date: 10/17/94

CORNER RECORD (PERPETUATION)

MONUMENT: DESCRIBE NEW MONUMENT SET, OR WORK DONE TO PRESERVE EXISTING MON.
Reset the BLM monument back in it's original hole and raised a mound of
stones around the monument.
From Which:

ACCESSORIES: DESCRIBE NEW BT'S, W.O.'S ETC. ESTABL./WORK DONE TO PRESERVE
5/8" x 30" rebar with yellow plastic cap marked PLS 2405 bears:

N45°W, 10.0 ft. (no grooves on rebar)

N45°E, 10.0 ft. (1 groove on rebar)

S45°E, 10.0 ft. (2 grooves on rebar)

S45°W, 10.0 ft. (3 grooves on rebar)

Measurements to rebars taken with a magnetic compass, declination 20° East,
and a nylon clad steel tape. Set steel fence post with Land Survey
Monument (54-9) sign 5' north of the monument.

Work Done by: Susan E. Newstetter Cr. Land Surveyor No. 2405 Date: 10/17/94
Certified Cor. Record Prepared? Yes No Filed At: Umatilla Co. Survey.

REMARKS

Index File No. V-15

T.4S., R.32E., W.M.