

USDA FOREST SERVICE

CORNER RECORD (SEARCH)

Index

File No. V-24

R.D.: N.F.J.D.

Co. Survey No:

T.4S., R.32E.

N.F.: UMATILLA

County: Umatilla

Meridian: Willamette

CORNER DIAGRAM

DESCRIBE CORNER MONUMENT FOUND

T4S R32E

S25

None. Corner established this survey.

E1/16

S36

1994

PLS 2405

DESCRIBE BEARING TREES OR OTHER OFFICIAL ACCESSORIES FOUND

None. Corner established this survey.

PHOTO ID DATA

Photo No.

Filed At

Object ID

PLANE CO-ORD

State Zone

X


Y

DESCRIBE CORNER LOCATION:

Estab.By

Corner falls on SE slope of pine and fir. Draw bottom runs S20°W, 130 feet east.

Signature:

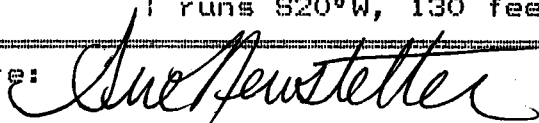

Title: Land Surveyor

Date: 11/4/94

CORNER RECORD (PERPETUATION)

MONUMENT: DESCRIBE NEW MONUMENT SET, OR WORK DONE TO PRESERVE EXISTING MON.  
Set 2-1/2"x30" aluminum pipe with 3-1/2" aluminum cap, stamped as shown  
on the DIAGRAM, 14" in the ground and raised a mound of stone 2 1/2 ft. dia. x  
1 1/2 ft. high around the monument. From Which:

ACCESSORIES: DESCRIBE NEW BT'S, W.O.'S ETC. ESTABL./WORK DONE TO PRESERVE  
Ponderosa Pine, 10" dia., bears N38°11'E, 44.9 ft., scribed: E1/16 S25 BT  
Douglas Fir, 16" dia., bears S51°54'W, 35.9 ft., scribed: E1/16 S36 BT  
Measurements to BT's taken with an Electronic Tacheometer with bearings  
based on the survey control network. Set steel fence post with Land Survey  
Monument (54-9) and Property Boundary (54-2) signs 5' west of the monument.  
Nailed a brass washer stamped PLS 2405 on blaze above BT scribe as taken  
this survey. Nailed Bearing Tree (54-3) signs above blaze and Land Survey  
Monument (54-9) signs on back of each tree as required. Painted a 6" red  
band above Bearing Trees signs.

Work Done by: Susan E. Newstetter Or. Land Surveyor No. 2405 Date: 11/4/94  
Certified Cor. Record Prepared?  Yes  No Filed At: Umatilla Co. Survey.

REMARKS

Index File No. V-24

T.4S., R.32E., W.M.