

USDA FOREST SERVICE

CORNER RECORD (SEARCH)

Index

File No. X-17

R.D.: N.F.J.D.

Co. Survey No:

T.4S., R.32E.

N.F.: UMATILLA

County: Umatilla

Meridian: Willamette

CORNER DIAGRAM | DESCRIBE CORNER MONUMENT FOUND

T4S R32E | Found original stone, 17"x16"x8" in bottom of rockjack.

1/4 | The stone is marked 1/4. I believe it is in it's

S34|S35 | original position.

1994

PLS 2405

| DESCRIBE BEARING TREES OR OTHER OFFICIAL ACCESSORIES FOUND

| None found, none originally set.

PHOTO ID DATA

Photo No.

Filed At

Object ID

PLANE CO-ORD

State Zone

X

Y

Estab.By | DESCRIBE CORNER LOCATION:

| Corner falls on open, gentle south slope. A N-S fence is

| 4 ft. east.

Signature:

Sue Hewstetter

Title: Land Surveyor Date: 11/3/94

CORNER RECORD (PERPETUATION)

MONUMENT: DESCRIBE NEW MONUMENT SET, OR WORK DONE TO PRESERVE EXISTING MON.
Moving the original corner stone aside I set in its place a 2-1/2"x30"
aluminum pipe with 3-1/2" aluminum cap, stamped as shown on the DIAGRAM, 6"
in the ground and raised a mound of stone 4 ft. dia. x 2 1/2 ft. high around
the monument. Place the original stone north alongside the monument From
which:

ACCESSORIES: DESCRIBE NEW BT'S, W.O.'S ETC. ESTABL./WORK DONE TO PRESERVE
5/8" x 30" rebar, set in a mound of stone 1 1/2 ft. high x 1 1/2 dia., with
yellow plastic cap marked PLS 2405 bears:
N42°45'W, 10.2 ft. (no grooves on rebar)
N54°15'W, 12.8 ft. (1 groove on rebar)
S51°00'E, 10.6 ft. (2 grooves on rebar)
S51°15'W, 10.6 ft. (3 grooves on rebar)
Measurements to BT's taken with a magnetic compass, declination 20° East,
and a nylon clad steel tape. Set steel fence post with Land Survey
Monument (54-9) sign 5' north of the monument. Nailed a brass washer
stamped PLS 2405 on blaze above BT scribe as taken this survey. Nailed
Bearing Tree (54-3) signs above blaze and Land Survey Monument (54-9) signs
on back of each tree as required. Painted a 6" red band above Bearing
Trees signs.

Work Done by: Susan E. Newstetter Or. Land Surveyor No. 2405 Date: 11/3/94
Certified Cor. Record Prepared? Yes No Filed At: Umatilla Co. Survey.

Index File No. X-17

T.4S., R.32E., W.M.

Index
File No. X-17

CORNER RECORD (SEARCH)


(Ref. FSM 7151.4)

Tract or Survey No. _____
Cor. No. _____

T 4S R. 32E R.D. NFJD County UMATILLA

Merid. WILLAMETTE N.F. UMATILLA State OR

CORNER DIAGRAM

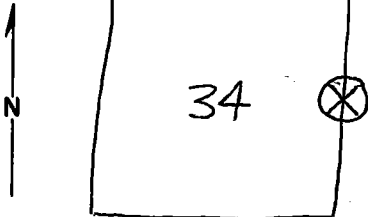

DESCRIBE CORNER MONUMENT FOUND

A STONE CLEARLY MARKED "1/4"

DESCRIBE BEARING TREES OR OTHER OFFICIAL ACCESSORIES FOUND

A ROCK CRIB MEASURING 4' x 4' x 4'.
THE CORNER STONE WAS AT THE BOTTOM OF THE CRIB. A K TAG DATED 1947, PENNOCK WAS POSTED TO THE CRIB.

DESCRIBE CORNER LOCATION RELATIVE TO NEAR-BY FEATURES, ALSO HOW TO REACH CORNER

FROM THE MONUMENT TO THE SECTION CORNER FOR SEC 34 & 35, T4S R32E AND SEC 2 & 3, T5S R32E FOLLOW THE FENCELINE 1/2 MILE NORTH.

PHOTO IDENTIFICATION DATA

Photo No. _____
Filed At. _____
Object Ident. _____
Ident. By _____
Signature

PLANE COORDINATE POSITION DATA

State _____ Zone _____
X _____
Y _____
Estab. By _____
Agency

Signature Rodney Lewis Title CORNER SEARCHER Division _____ Headquarters ENG PENNOCK Date 8-23-88

CORNER RECORD (PERPETUATION)

MONUMENT: DESCRIBE NEW MONUMENT SET, OR WORK DONE TO PRESERVE EXISTING MONUMENT

9

ACCESSORIES : DESCRIBE NEW BT's WITNESS OBJECTS ETC. ESTABLISHED, OR WORK DONE TO PRESERVE EXISTING EVIDENCE

10

Work Done By _____ Title _____ Date _____ State Registration No.
or Agency _____

Certified Cor. Record Prepared ? Yes No Filed At: _____ Date _____

11

REMARKS

12

Index File No. T. R. M. Tract or Surv. No. Cor. 13