


USDA-FOREST SERVICE

Index  
File No. X-25  
T 4S R. 32E  
Merid. Willamette

CORNER RECORD (SEARCH)  
(Ref. FSM 7151.4)

Tract or  
Survey No. Sec 36 Cor. No. E 1/4  
County Umatilla  
State Oregon

R.D. Ukiah  
N.F. Umatilla

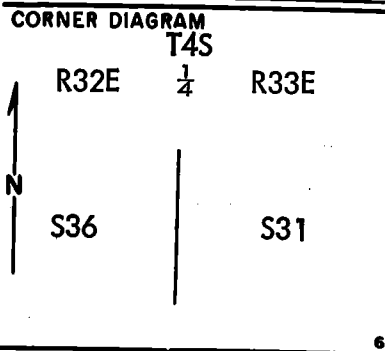

DESCRIBE CORNER MONUMENT FOUND  
None

DESCRIBE BEARING TREES OR OTHER OFFICIAL ACCESSORIES FOUND  
None. Corner set by single proportionate measure.

PHOTO IDENTIFICATION DATA  
Photo No. \_\_\_\_\_  
Filed At. \_\_\_\_\_  
Object Ident. \_\_\_\_\_  
Ident. By \_\_\_\_\_  
*Signature*

DESCRIBE CORNER LOCATION RELATIVE TO NEAR-BY FEATURES, ALSO HOW TO REACH CORNER  
Drive east from Ukiah along highway 244, 12 miles approximately to area where corrals and loading chutes are on the east side of the highway, corner is 150' east of highway and 20' north of corrds.

PLANE COORDINATE POSITION DATA  
State \_\_\_\_\_ Zone \_\_\_\_\_  
X \_\_\_\_\_  
Y \_\_\_\_\_  
Estob. By \_\_\_\_\_  
*Agency*

Signature  
*William R. Wells*

Title PLS 1106 Division \_\_\_\_\_ Headquarters \_\_\_\_\_ Date 7-26-79  
7100-52-(3/68)

**CORNER RECORD (PERPETUATION)**

**MONUMENT: DESCRIBE NEW MONUMENT SET, OR WORK DONE TO PRESERVE EXISTING MONUMENT**

Set 2" x 30" galvanized iron pipe with brass cap 26 inches in ground with a mound of stone marked:

Set steel fence post south of corner and attached signs 54-4 & 54-2.

T4S  
R32E  $\frac{1}{4}$  R33E  
S36  $\frac{1}{4}$  S31  
1979  
PLS 1106

**ACCESSORIES : DESCRIBE NEW BT'S WITNESS OBJECTS ETC. ESTABLISHED, OR WORK DONE TO PRESERVE EXISTING EVIDENCE**

An 18" tamarack bears N 25° W 76.3 ft. to center scribed  $\frac{1}{4}$  S 36 BT.

A 15" red fir bears N 1° W 43.2 ft. to center scribed  $\frac{1}{4}$  S 31 BT.

BT's have a lower blaze scribe BT with a brass washer stamped PLS 1106 nailed flush.

Attached signs 54-3 & 54-4 to BT's and painted 6" red ring around tree above top blaze.

10

Work Done By William R. Wells Title PLS Date 7-26-79 State Registration No. 1106  
or Agency

Certified Cor. Record Prepared? Yes  No  Filed At Umatilla County Surveyor's Office Date \_\_\_\_\_ 11

Witnesses: Greg Flowers, L.S.I.T.  
Brent Reynolds

**REMARKS**

There has been a lot of human activity in this area and Camas Creek has changed course several times. We found no traces of trees or corner.

12