

USDA FOREST SERVICE

CORNER RECORD (SEARCH)

Index

File No. T-25

R.D.: N.F.J.D.

Co. Survey No:

T.4S., R.32E.

N.F.: UMATILLA

County: Umatilla

Meridian: Willamette

CORNER DIAGRAM | DESCRIBE CORNER MONUMENT FOUND

T4S

| Found iron monument, in a mound of stone, with a brass cap marked as shown in DIAGRAM. Monument is solid and firm.

1/4

R32E R33E

S25|S30

1977

(BLM Cap)

| DESCRIBE BEARING TREES OR OTHER OFFICIAL ACCESSORIES FOUND

PHOTO ID DATA

| Western Larch stump, 20" dia, with scribing 1/4 S BT visible, bears S60°38'W, 2.0 ft. (Org. Rec: S60°W, 1.98ft)

Photo No.

Filed At

| Douglas Fir, 14" dia., with healed blaze, bears N74°50'E, 13.0 ft. (BLM Rec: N83°E, 13.86 ft.)

Object ID

PLANE CO-ORD

State Zone

X

Y

| DESCRIBE CORNER LOCATION:

Estab.By

| And old N-S road is approx. 50 ft. east.

Signature:

Jue Newstetter

Title: Land Surveyor

Date: 10/17/94

CORNER RECORD (PERPETUATION)

MONUMENT: DESCRIBE NEW MONUMENT SET, OR WORK DONE TO PRESERVE EXISTING MON.
No work is needed on the monument.
From Which:

ACCESSORIES: DESCRIBE NEW BT'S, W.O.'S ETC. ESTABL./WORK DONE TO PRESERVE
Western Larch, 18" dia., bears S82°00'E, 40.8 ft., scribed: 1/4 S30 BT
Western Larch, 6" dia., bears S32°30'W, 14.8 ft., scribed: X BT
Lodgepole Pine, 8" dia., bears N83°15'W, 15.5 ft., scribed: 1/4 S25 BT
Measurements to BT's taken with a magnetic compass, declination 20° East,
and a nylon clad steel tape. Set steel fence post with Land Survey
Monument (54-9) sign 5' north of the monument. Nailed a brass washer
stamped PLS 2405 on blaze above BT scribe as taken this survey. Nailed
Bearing Tree (54-3) signs above blaze and Land Survey Monument (54-9) signs
on back of each tree as required. Painted a 6" red band above Bearing
Trees signs.

Work Done by: Susan E. Newstetter Dr. Land Surveyor No. 2405 Date: 10/17/94
Certified Cor. Record Prepared? Yes No Filed At: Umatilla Co. Survey.

REMARKS

Index File No. T-25

T.4S., R.32E., W.M.


Index
File No. T-1T 4S R. 33EMerid. Willamette

CORNER RECORD (SEARCH)

(Ref. FSM 7151.4)

Tract or
Survey No. S-17 Cor.
No. T-1R.D. Ukiah County UmatillaN.F. Umatilla State Oregon

CORNER DIAGRAM

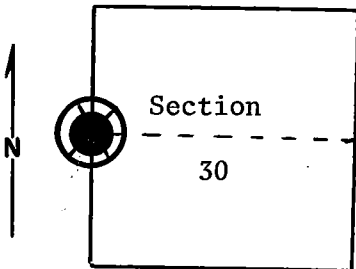

DESCRIBE CORNER MONUMENT FOUND

Material: Basalt stone. Size: 6" x 8" x 10".

*Brass Cap! See Monumentation File*8 inches above ground; fair condition. Appears to have $\frac{1}{4}$ on east face. Not clear.

DESCRIBE BEARING TREES OR OTHER OFFICIAL ACCESSORIES FOUND

A western larch stump, approximately 16 inches D.B.H., and 5 feet tall, bears SW approximately 2 feet from stone. It is scribed $\frac{1}{4}$ S, B.T. (on east face). No evidence of other accessories. (B.T. stump also has old location poster on it--1944.) The location poster shows T4S, R32E, and the tack is at the west $\frac{1}{4}$ corner to Section 30. It should be the common $\frac{1}{4}$ corner for west side of Section 30, T4S, R33E and the east side of Section 25, T4S, R32E.

DESCRIBE CORNER LOCATION RELATIVE TO NEAR-BY FEATURES, ALSO HOW TO REACH CORNER

Approximately 150 feet north of forks of small stream. On top of low spur ridge. From Highway 244, proceed approximately 0.6 miles NW up next small drainage below Lane Creek Campground (about 1000 feet below campground).

PHOTO IDENTIFICATION DATA

Photo No. _____

Filed At. _____

Object Ident. _____

Ident. By _____

Signature

PLANE COORDINATE POSITION DATA

State _____ Zone _____

X _____

Y _____

Estab. By _____

Agency

Signature

Title

Division

Headquarters

Date

T, Hollamon

Engineering Technician

S, O.

April 5, 1974

7100-52-(3/68)

CORNER RECORD (PERPETUATION)

MONUMENT : DESCRIBE NEW MONUMENT SET, OR WORK DONE TO PRESERVE EXISTING MONUMENT

ACCESSORIES : DESCRIBE NEW BT's WITNESS OBJECTS ETC. ESTABLISHED, OR WORK DONE TO PRESERVE EXISTING EVIDENCE

I placed 3 blank B.T. tags around the B.T. stump.

Work Done By _____ Title _____ Date _____ State Registration No. or Agency _____

Certified Cor. Record Prepared ? Yes No Filed At: _____ Date _____

REMARKS

Index File No. T. R. M. Tract or Surv. No. Cor.