


USDA-FOREST SERVICE

Index
File No. X-25
T 4S R. 32E
Merid. Willamette

CORNER RECORD (SEARCH)
(Ref. FSM 7151.4)

Tract or
Survey No. Sec 36 Cor. No. E 1/4
County Umatilla
State Oregon

R.D. Ukiah
N.F. Umatilla

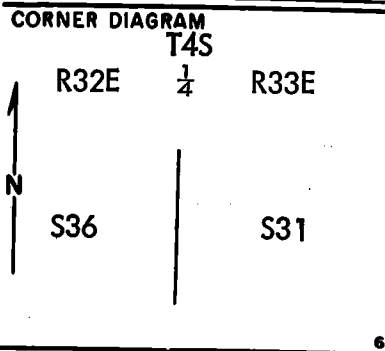

DESCRIBE CORNER MONUMENT FOUND
None

DESCRIBE BEARING TREES OR OTHER OFFICIAL ACCESSORIES FOUND
None. Corner set by single proportionate measure.

PHOTO IDENTIFICATION DATA
Photo No. _____
Filed At. _____
Object Ident. _____
Ident. By _____
Signature

DESCRIBE CORNER LOCATION RELATIVE TO NEAR-BY FEATURES, ALSO HOW TO REACH CORNER
Drive east from Ukiah along highway 244, 12 miles approximately to area where corrals and loading chutes are on the east side of the highway, corner is 150' east of highway and 20' north of corrds.

PLANE COORDINATE POSITION DATA
State _____ Zone _____
X _____
Y _____
Estob. By _____
Agency

Signature
William R. Wells

Title PLS 1106 Division _____ Headquarters _____ Date 7-26-79
7100-52-(3/68)

CORNER RECORD (PERPETUATION)

MONUMENT: DESCRIBE NEW MONUMENT SET, OR WORK DONE TO PRESERVE EXISTING MONUMENT

Set 2" x 30" galvanized iron pipe with brass cap 26 inches in ground with a mound of stone marked:

Set steel fence post south of corner and attached signs 54-4 & 54-2.

T4S
R32E $\frac{1}{4}$ R33E
S36 $\frac{1}{4}$ S31
1979
PLS 1106

ACCESSORIES : DESCRIBE NEW BT'S WITNESS OBJECTS ETC. ESTABLISHED, OR WORK DONE TO PRESERVE EXISTING EVIDENCE

An 18" tamarack bears N 25° W 76.3 ft. to center scribed $\frac{1}{4}$ S 36 BT.
A 15" red fir bears N 1° W 43.2 ft. to center scribed $\frac{1}{4}$ S 31 BT.
BT's have a lower blaze scribe BT with a brass washer stamped PLS 1106 nailed flush.
Attached signs 54-3 & 54-4 to BT's and painted 6" red ring around tree above top blaze.

10

Work Done By William R. Wells Title PLS Date 7-26-79 State Registration No. 1106
or Agency _____
Certified Cor. Record Prepared? Yes No Filed At Umatilla County Surveyor's Office Date _____

11

Witnesses: Greg Flowers, L.S.I.T.
Brent Reynolds

REMARKS
There has been a lot of human activity in this area and Camas Creek has changed course several times. We found no traces of trees or corner.