


CERTIFIED RECORD OF LAND CORNER MONUMENTATION

History of original corner establishment:

None

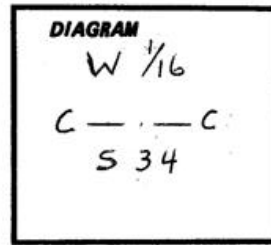

X-14

Description of corner evidence found:

None

Description of monument and accessories I established to perpetuate the original location of this corner:

Set a 2½" Brass Cap on a 2½" x 30" Galvanized Pipe set 22" in the ground marked as shown:

From which:

A 26" Pine bears N45°30'W 111.20 ft. scribed CW 1/16 S 34 BT
A 17" Pine bears N 5° E 216.8 ft. scribed CW 1/16 S 34 BT

Blazes are painted red and have red bands painted around them.

Trees have signs Numbers 54-3, 54-9 and brass washers stamped PLS 933 nailed to them.


Bearings were run with a staff compass set at a declination of 19°30'E.

Distances were measured with a steel tape to the center of the tree.

This corner was set Oct. 2, 1983.

By: Rod Punches

Witness: Brent Reynolds

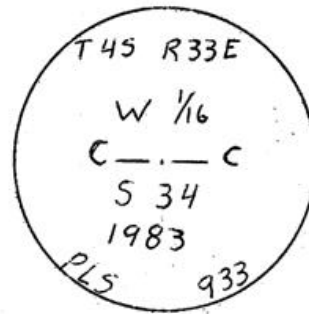

REGISTERED
PROFESSIONAL
LAND SURVEYOR

David H. Krumbein

OREGON
JULY 17, 1970
DAVID H. KRUMBEIN
933

Office of..... County Surveyor County of..... Umatilla
 State of..... Oregon I hereby certify that the within instrument was filed in this office
 for record on the 26th day of November, 1984
 by Billy Jackson
 (COUNTY OFFICIAL) (DEPUTY)