

Index File No. Y-17

T 45 R. 33E

Merid. Willamette

CORNER RECORD (SEARCH)

(Ref. FSM 7151.4)

R.D. UKiah

County Umatilla


N.F. Umatilla

State Oregon

Tract or Survey No. \_\_\_\_\_

Cor. No. S 1/4

CORNER DIAGRAM

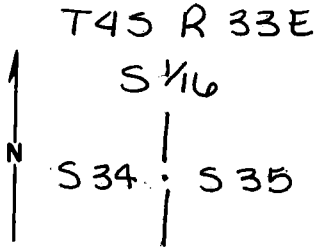

DESCRIBE CORNER MONUMENT FOUND

NONE

DESCRIBE BEARING TREES OR OTHER OFFICIAL ACCESSORIES FOUND

NONE

PHOTO IDENTIFICATION DATA

Photo No. \_\_\_\_\_

Filed At. \_\_\_\_\_

Object Ident. \_\_\_\_\_

Ident. By \_\_\_\_\_

*Signature*

PLANE COORDINATE POSITION DATA

State \_\_\_\_\_ Zone \_\_\_\_\_

X \_\_\_\_\_

Y \_\_\_\_\_

Estob. By \_\_\_\_\_

*Agency*

DESCRIBE CORNER LOCATION RELATIVE TO NEAR-BY FEATURES, ALSO HOW TO REACH CORNER

From Jct of UKiah-Hilgard Hwy & Forest Rd  
54 go East 0.8 mi., park & walk North  
350 Ft. to corner

Signature  
David H Klein

Title AS 933 Division

Headquarters

Date 1/83 7100-52 (3. 68)

**CORNER RECORD (PERPETUATION)**

**MONUMENT: DESCRIBE NEW MONUMENT SET, OR WORK DONE TO PRESERVE EXISTING MONUMENT**

Set a 2 1/2" Brass Cap on a 2 1/2" x 30" Galvanized Pipe  
Set 24" in Ground Marked!

T45 R33E  
S 1/4  
S 34 & S 35  
1983  
PLS 933

**ACCESSORIES: DESCRIBE NEW BT'S WITNESS OBJECTS ETC. ESTABLISHED, OR WORK DONE TO PRESERVE EXISTING EVIDENCE**

A 12" Pipe bears N 24° 30' W 60.9 Ft. Scribed 1/16 S 34 BT

A 40" Pipe bears N 61° 30' E 162.0 Ft. Scribed 1/16 S 35 BT

Blazes are Painted red & have red bands Painted Around them.  
Trees have signs numbers 54-3, 54-9 & Brass Washers Stamped  
PLS 933 Nailed to them.

Work Done By D. Krumbein Title Surveyor Date 7/83 State Registration No. PLS 933  
or Agency

Certified Cor. Record Prepared?  Yes No Filed At: Umatilla County Date 10/1983

**REMARKS**

Fence running N-S lies 28' West