

Index

File No. T-25

T 4S R. 33 1/2 E

Merid. Willamette

CORNER RECORD (SEARCH)

(Ref. FSM 7151.4)


R.D. LaGrande County Union

N.F. W-W State Oregon

Tract or Survey No. _____

Cor. No. _____

CORNER DIAGRAM

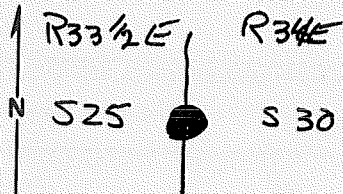

DESCRIBE CORNER MONUMENT FOUND

original unmarked basalt stone, 15 x 15 x 6", set 6" in the ground

DESCRIBE BEARING TREES OR OTHER OFFICIAL ACCESSORIES FOUND

a pine snag, 9" dia, brs S 83 E, 25 ft w/loated blaze

PHOTO IDENTIFICATION DATA

Photo No. _____

Filed At. _____

Object Ident. _____

Ident. By _____

Signature

PLANE COORDINATE POSITION DATA

State _____ Zone _____

X _____

Y _____

Estab. By _____

Agency

Signature

Title

Division

Headquarters

Date

7100-52 (3-68)

6

7

8

2

3

4

5

CORNER RECORD (PERPETUATION)

MONUMENT: DESCRIBE NEW MONUMENT SET, OR WORK DONE TO PRESERVE EXISTING MONUMENT

Set Brass cap mtd:

T4S
1/4
R33 1/2 E | R 34 E
S 25 | S 30
1977

ACCESSORIES: DESCRIBE NEW BT'S WITNESS OBJECTS ETC. ESTABLISHED, OR WORK DONE TO PRESERVE EXISTING EVIDENCE

a lodgepole pine, 8" dia., brs S36E, 81 lbs, mtd 1/4 S30 BT

a " " " " brs N39W, 22 lbs mtd 1/4 S25 BT

Deposit corner stone and set a 5 ft steel fence post alongside
mon post.

Work Done By: BCM Title _____ Date 9/77 State Registration No. _____ or Agency _____

Certified Cor. Record Prepared? Yes No Filed At: _____ Date _____

REMARKS

Index
File No. T-25

CORNER RECORD (SEARCH)
(Ref. FSM 7151.4)

Tract or
Survey No. _____ Cor. No. T-25


T 4 S R. 33 1/2 E

R.D. Umatilla County Umatilla

Merid. Will.

N.F. Umatilla State Oregon

CORNER DIAGRAM

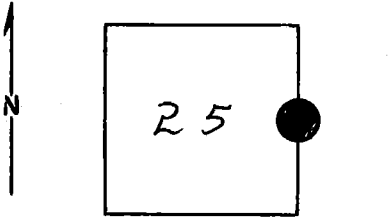

DESCRIBE CORNER MONUMENT ~~FOUND~~ SET

Brass Cap! 1977

DESCRIBE BEARING TREES OR OTHER OFFICIAL ACCESSORIES FOUND

Notes on file! See Monumentation File

PHOTO IDENTIFICATION DATA

Photo No. _____
Filed At. _____
Object Ident. _____
Ident. By _____
Signature

DESCRIBE CORNER LOCATION RELATIVE TO NEAR-BY FEATURES, ALSO HOW TO REACH CORNER

PLANE COORDINATE POSITION DATA

State _____ Zone _____
X _____
Y _____
Estab. By _____
Agency

Signature _____ Title _____ Division _____ Headquarters _____ Date _____

CORNER RECORD (PERPETUATION)

GPO 902-673

MONUMENT : DESCRIBE NEW MONUMENT SET, OR WORK DONE TO PRESERVE EXISTING MONUMENT

9

ACCESSORIES : DESCRIBE NEW BT'S WITNESS OBJECTS ETC. ESTABLISHED, OR WORK DONE TO PRESERVE EXISTING EVIDENCE

10

Work Done By _____ Title _____ Date _____ State Registration No. or Agency _____

Certified Cor. Record Prepared ? Yes No Filed At: _____ Date _____

11

REMARKS

Index File No. T. R. M. Tract or Surv. No. Cor.

12

13