

OREGON CORNER RESTORATION FORM

COUNTY: Umatilla Date: April 3, 2013

CORNER DESIGNATION: F-13 Meander Corner for Sections 9 & 10 Township 5 North, Range 28 E. W.M.

PREVIOUS RENEWALS/SURVEYS ETC.

1861 GLO survey by Timothy W. Davenport, set a charred stake in a mound.



Record of Survey, PLS 64248, recorded as Umatilla County Surveyor No. 13-129-B on 3/27/13.

MONUMENT AND ACCESSORIES FOUND:

No evidence found.

MONUMENT SET:

Set a 3/4" Aluminum cap on a 5/8" Rebar 0.4' below ground.

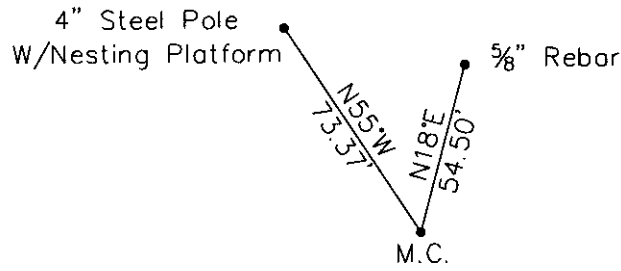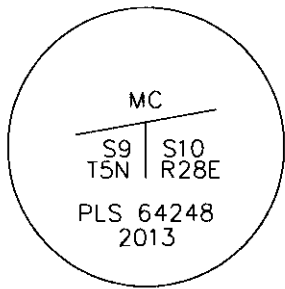

NEW ACCESSORIES:

- A Found 5/8" rebar bears N18°E, 54.50' dist.
- A 4" Steel pole +/- 30' tall with nesting platform bears N55°W, 73.37' dist.
- A Carsonite post with survey marker decal bears east 1.2' dist.

LOCATION AND COMMENTS: N/A

COMPASS DECLINATION: 15° E

FIRM/AGENCY: Columbia Surveys, PLLC
303 Church Street
Sandpoint, ID 83864

PARTY CHIEF: S. Jeske

NOTES: N/A

WITNESS: B. Staples

REGISTERED
PROFESSIONAL
LAND SURVEYOR

OREGON
SEPTEMBER 25 2000
RONALD M. HODGE
6 4 2 4 8

04-11-2013

RENEWAL DATE: JUNE 30 2013

RECEIVED BY

Umatilla County Surveyor

Date: 3/15/13

Rec'd By: S. Jeske

No.: 13-129-B