

OREGON CORNER RESTORATION FORM

Section: 9 - 10
Township: 5 North
Range: 28 East of the Willamette Meridian
County: Umatilla
Date: January 2024

Corner Indexing Information: Township 5N Range 28E Corner Code G-13
(Willamette Meridian)

Additional Identifier: Quarter corner between sections 9 & 10

Oregon Plane Coordinates: N: 827454.50 E: 8505541.00 Zone: North Order: second

Datum: NAD83-2011(epoch 2010) **Convergence:** N00°50'45"W **Scale Factor:** 1.000044268448

Previous Renewals/Surveys, etc.:

1861: post, mound, pits, & charred stake (Davenport, General Land Office Contract #101)

2013: 5/8" rebar with 3.25" aluminum cap 0.3' deep set by Hodge PLS #64248 per survey 13-129-B the record states: a 3/8" rebar and cap bears N50°E 18.77 feet; TWR footing bears S64°E 41.1 feet; the NE corner of a bridge bears S25°W 12.0 feet; a 3/8" rebar and cap bears N32°W 11.72 feet.


Monument(s) & Accessories Found (Condition & Source):

3-1/4" aluminum cap 2" deep in the west edge of the trail.

Monument Set (Procedures & Description):

Found 3-1/4" aluminum cap as noted above.

Monument Detail:

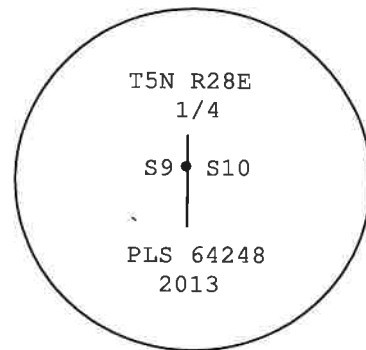

New Accessories: WE SET:

Set a T-post with bearing tag & a 5/8" iron rebar with plastic cap stamped "PBS WA-19619 OR-2820" which bears S60°31'09"E 40.60 feet from the corner.

Set a T-post with bearing tag & a 5/8" iron rebar with plastic cap stamped "PBS WA-19619 OR-2820" which bears S52°44'03"W 58.24 feet from the corner.

Set a T-post with bearing tag & a 5/8" iron rebar with plastic cap stamped "PBS WA-19619 OR-2820" which bears N19°19'17"W 61.19 feet from the corner.

Set a T-post with bearing tag & a 5/8" iron rebar with plastic cap stamped "PBS WA-19619 OR-2820" which bears N69°19'06"E 49.60 feet from the corner.

Location & Comments:

Compass Declination:

All accessories tied with State Plane grid bearings.

Firm/Agency: PBS Engineering & Environmental, Inc
5 N. Colville
Walla Walla WA 99362

Witness: Mark F. Wendover

Surveyor's Seal

REGISTERED
PROFESSIONAL
LAND SURVEYOR

OREGON
JUNE 30, 1997
GREG E. FLOWERS
02820LS

RENEWS 12/31/2025
1/24/2024