

**CERTIFIED RECORD OF LAND CORNER MONUMENTATION**

COUNTY: Umatilla      DATE: May 17, 2017

CORNER DESIGNATION: L-7, Center One-quarter Corner Section 17, T.5N., R.28E., W.M.

**HISTORY OF ORIGINAL CORNER ESTABLISHMENT:**

Original GLO Survey of the subdivision lines and meanders of the Columbia River by T.W. Davenport, under Contract No. 101, dated August 5<sup>th</sup>, 1861.

Center One-quarter Corner set by John W. Kimbrell, Umatilla County Surveyor for the City of Umatilla, Umatilla Record of Survey No. 251, dated February 28<sup>th</sup>, 1907. Record states "set iron bar for center Sec 17"

Other Umatilla Co. survey records:

Umatilla Co. Survey No. B-17-A: "Stone w/ "X" 3/4" I.P. alongside"


Umatilla Co. Survey No. L-79-C: "Found Stone with + in top and 3/4" iron pipe alongside"

Umatilla County Survey No. 083-201-B: "Reconstructed from CS # L-79",

Umatilla County Survey No. 00-064-B: "Computed Location C 1/4, sec 17 from Griffis 983 Survey"

L-7

T.5 N., R.28E., W.M.

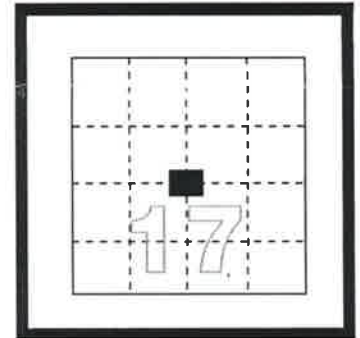

DIAGRAM

**DESCRIPTION OF MONUMENT FOUND:**

April 11, 2017: Found 3/4" diameter Iron Pipe buried 1.1 feet. Found stone, buried 1.5 feet, with visible "X" on top, stone bears S41° 36' 24"E, 0.37' from Iron Pipe

Iron Pipe and Stone are located approximately 7 feet Northwesterly of Second Base at the Umatilla School District No. 6 baseball field.


**DESCRIPTION OF ACCESSORIES I ESTABLISHED TO PERPETUATE THE ORIGINAL LOCATION OF THIS CORNER:**

New accessories:

Stamped "X" & "APA RP" in top of metal fence post set in concrete at SE end of gate to bull pen. Fence post bears N70°26'42"W, 113.82' from Iron Pipe

Etched "X" in concrete at the SE corner of concrete slab in front of ticket & concession stand. "X" is 0.6' from SE corner of concrete slab. "X" bears N31°25'55"W, 169.88' from Iron Pipe

Etched "X" in concrete at the SW corner of concrete slab of batting practice building. "X" is 1.3' from SW corner slab. "X" bears N74°41'26"E, 190.20' from Iron Pipe

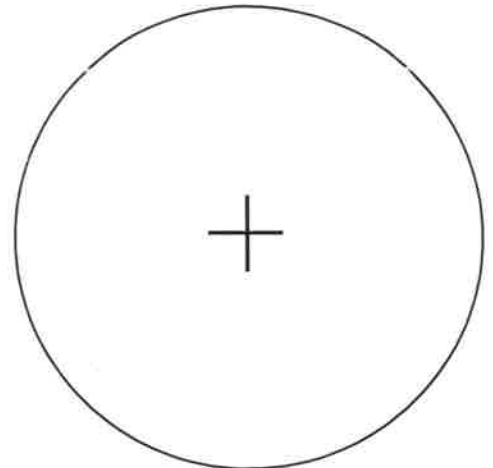

**SPCS OREGON NORTH (International Feet)**

NAD83 (2011)

Northing: 821944.62

Easting: 8497696.76

I hereby certify that the above survey monument was found as hereon described on April 11, 2017.

Witness: Jarrod Hayes, LSIT  
Anderson Perry & Assoc., Inc.  
1901 N. Fir Street  
La Grande, Oregon 97850  
(541)963-8309



EXPIRES: 12-31-2018

SIGNED: 05-17-2017

**RECEIVED BY**  
Umatilla County Surveyor  
Date: 8/4/17  
Rec'd By: CT  
No.: 17-096-R