

OREGON CORNER RESTORATION FORM

SECTION 21 TOWNSHIP 5N RANGE 28E N-11

COUNTY: UMATILLA DATE 4/90

CORNER DESIGNATION

N 1/4 Corner

- CONDITION REPORT ONLY
- NOT FOUND
- RENEWED
- UNRECORDED
- SURVEYED IN
- REFERENCED OUT


PREVIOUS RENEWALS/SURVEYS, ETC.

Original Survey by Davenport in 1861. He set post. In Dependent Resurvey by Tuers in 1975 a 2 1/2" x 28" Iron Pipe with 3 1/2" B.C. was set.


MONUMENTS & ACCESSORIES FOUND: Condition and Source

Found 3 1/2" B.C. on 2 1/2" iron Pipe stamped as below. Found a steel fence post S 88° 52'W 2.00 feet.

MONUMENT DETAIL

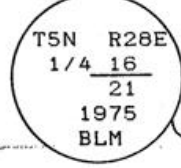

SKETCH

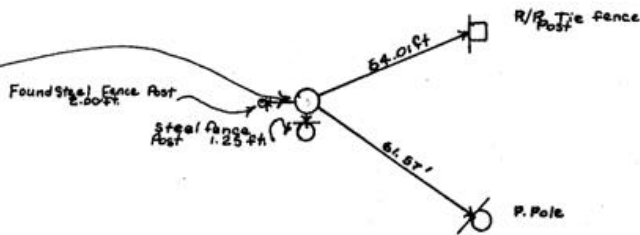

MONUMENT SET (PROCEDURES AND DESCRIPTION)

NEW ACCESSORIES

Alum. Tag in RR tie fence post Bears N 67° 11'E 54.01 feet, Alum. Tag in Power pole Bears S 55° 44'E 61.57 feet. A steel fence post Bears S 02° 38 W 1.25 feet. Attached Bearing Object signs & Warning signs to new accessories and the found steel fence post.

LOCATION & COMMENTS

From I 82 overpass on River Rd., go East 0.5 miles along fence line to corner. Lies on South edge gravel operation.

SURVEYOR'S SEAL

COMPASS DEC. FIRM EDWARDS SURVEYING P.O. BOX 763, HERMISTON, OREGON, 97838 PARTY CHIEF D. EDWARDS NOTES WITNESS J. COPPOCK

REGISTERED PROFESSIONAL LAND SURVEYOR

G. Dennis Edwards OREGON JULY 18, 1971 G. DENNIS EDWARDS 951

RECEIVED BY

Umatilla County Surveyor Date 1-91 Rec'd By KA No. 91-01-B