

OREGON CORNER RESTORATION FORM

Section 26 Township 5N Range 28 E

County Umatilla Date 5/23/96

V-19

CORNER DESIGNATION

3/4 Corner


- Condition Report Only
- Not Found
- Renewed
- Unrecorded
- Surveyed In
- Referenced Out

Previous Renewals/Surveys, etc. Davenport set post in mound with charred stake in 1861; Thompson set iron pipe in 1972; Edwards set 1" x 30" iron pipe with brass cap in 1988.

Monument(s) & Accessories Found: (Condition and Source)

Edwards' brass cap and the 5/8" rebar to the southeast used as a reference point (NW corner Block 5, Landover Hills) from survey #88-45-C were found intact; the reference pin to the southwest (NE corner of Block 3, Landover Hills) was found to be destroyed. The corner was referenced to a 5/8" rebar to the northeast (southwest corner of Lot 4, Pihl Subdivision) after determining it would be destroyed during road construction. No other monuments or accessories were found in the area.

Monument Detail

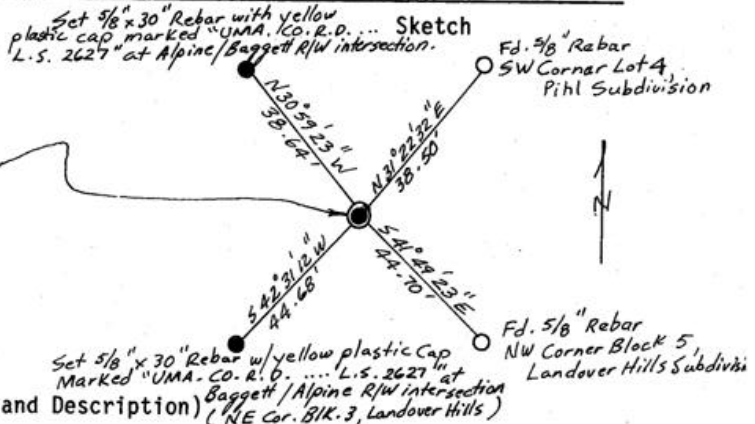

Monument Set (Procedures and Description)

After Edwards' monument was destroyed, a 2 3/8" brass cap on a 1 1/4" x 30" galvanized iron pipe was set from the reference pins on the northeast and southeast shown above. Brass cap was stamped as shown above.

New Accessories

5/8" x 30" rebars with yellow plastic caps stamped "UMA. CO. R.D. L.S. 2627" were set at the intersection of Baggett Lane and Alpine Drive right-of-way lines in the NW and SW quadrants as shown above. "Do not disturb nearby survey marker" and "Bearing Object" tags were placed on metal fence posts and set near the NW, SW, and S.E. pins.

Location & Comments

Go east on Baggett Lane approximately 0.7 mile from U.S. Highway 395 to a "T" intersection with Alpine Drive. Monument is set 10" below gravel surface in the intersection.

Compass Declination _____
 Firm/Agency Umatilla County Public Works Department
 Address 3920 Westgate Pendleton, Oregon
 Party Chief Gary Roberts
 Notes Gary Roberts
 Witness Charlie Good

Surveyor's Seal

REGISTERED PROFESSIONAL LAND SURVEYOR

Gary R. Roberts
 OREGON
 JULY 20, 1893
 GARY R. ROBERTS
 2627

Renews 12/31/96

Umatilla County Surveyor

Date 5-26
 Rec'd by AK
 No. 96-84-R